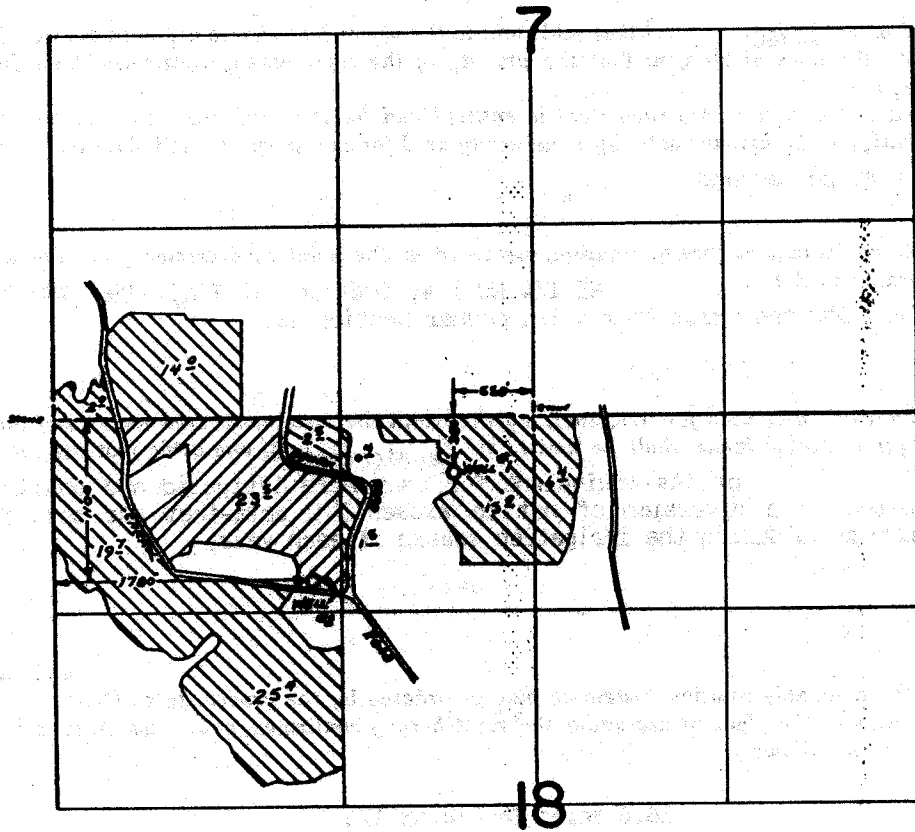

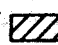


# T.2N.,R.12E.,W.M.



## FINAL PROOF SURVEY UNDER

Application No. G-8296 G-7681  
 G-10717.. Permit No. G-9795..  Well #1  Well #2  
 IN NAME OF

**BRYCE W. MOLESWORTH**

Surveyed Sept. 30. 1982., by T.J. PAUL.....