


T. 1 S., R. 2 W., W. M.

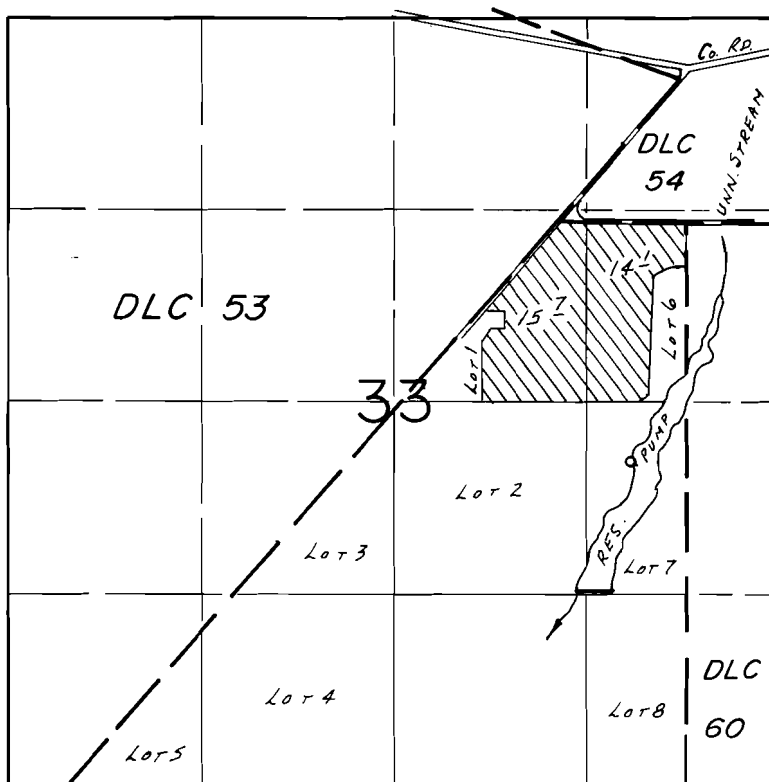

DAM LOC.: 1300 S. 8' 1/2 275' W. FROM E. 1/4 COR. SEC. 33.

SCALE: 1" = 1320'

FINAL PROOF SURVEY UNDER

Application No. 58676. Permit No. 44860....
IN NAME OF

..... T. F. L. TRUST

Surveyed July 15... 19.86, by B.W. BISHOP.....

11/20/02
RWB