


T. 1S., R. 2W., W.M.

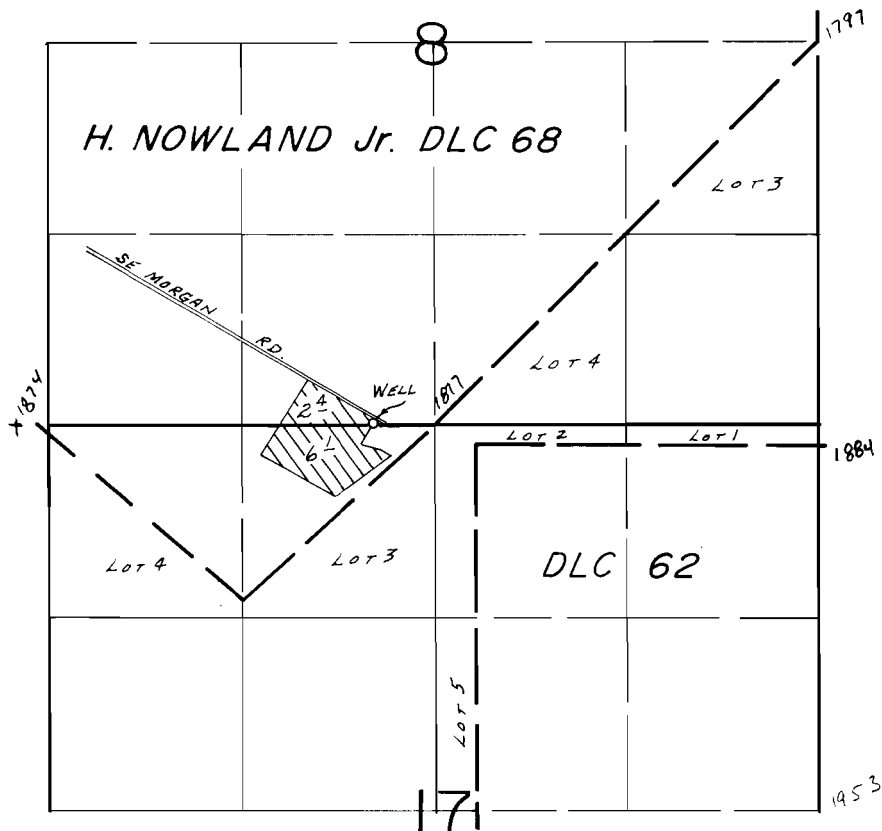

WELL LOC.: 20' N. & 420' W. FROM S 1/4 COR. SEC 8.

SCALE: 1" = 1320'

FINAL PROOF SURVEY UNDER

Application No. G:11264 Permit No. G:10437...
IN NAME OF

.....ATSUSHI ENDO.....

Surveyed July 14, 1986, by B.W. BISHOP.....

11/26/86
JWB

41067-178-160D