


P-38066
58850

T.9&10S., R.21E., W.M.

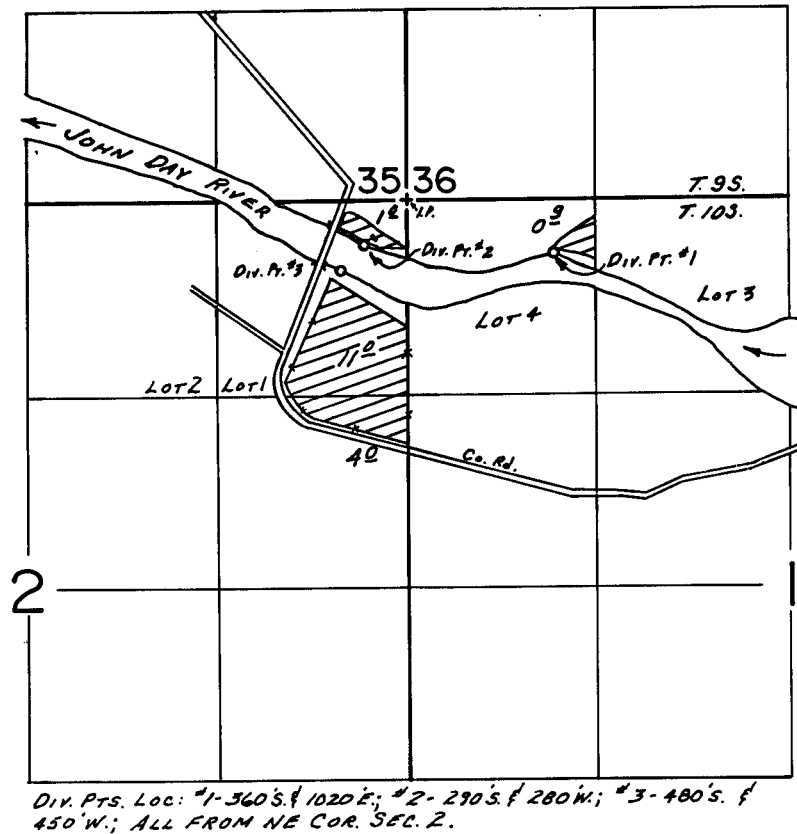

FINAL PROOF SURVEY
UNDER

Application No. 52684... Permit No. 38066.....
IN NAME OF

.....CHARLES D. POWELL.....

Surveyed JUNE 26, 1980, by S.C. BROWN.....