


# T. 8S., R. 40E., W.M.

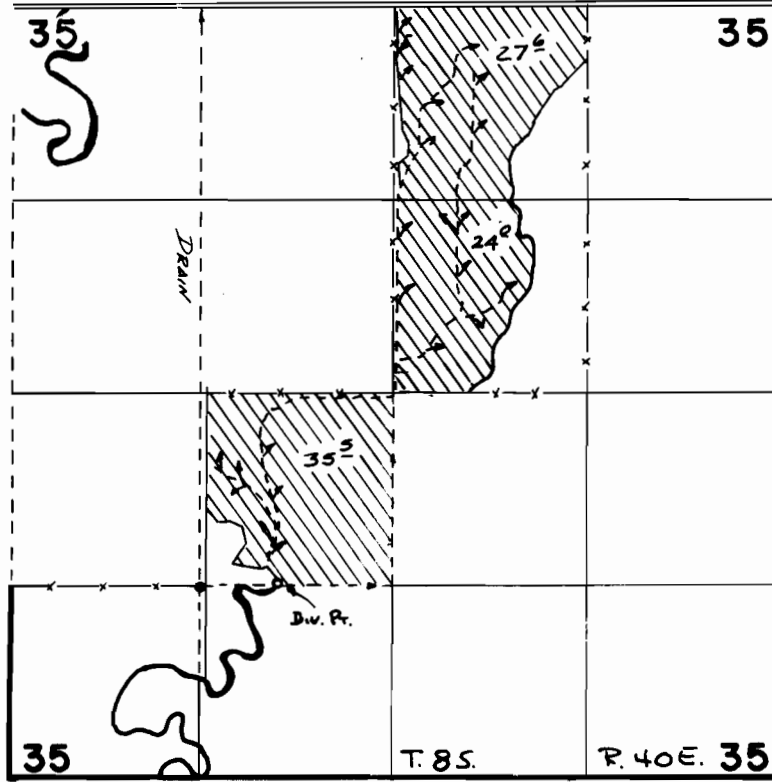

SCALE 1"=1320'

Div. Pt. Loc: 1330' N. & 790' W. From S 1/4 COR SEC 35

## FINAL PROOF SURVEY UNDER

Application No. **45838** Permit No. **34291**.....  
IN NAME OF

.....**WILLIAM R. PEYRON**.....

Surveyed ~~5-25~~ **1978**, by ~~R. BARWIN~~  
*6-2 86 V. CHURCH*