


T. 27S., R. 13W., W.M.

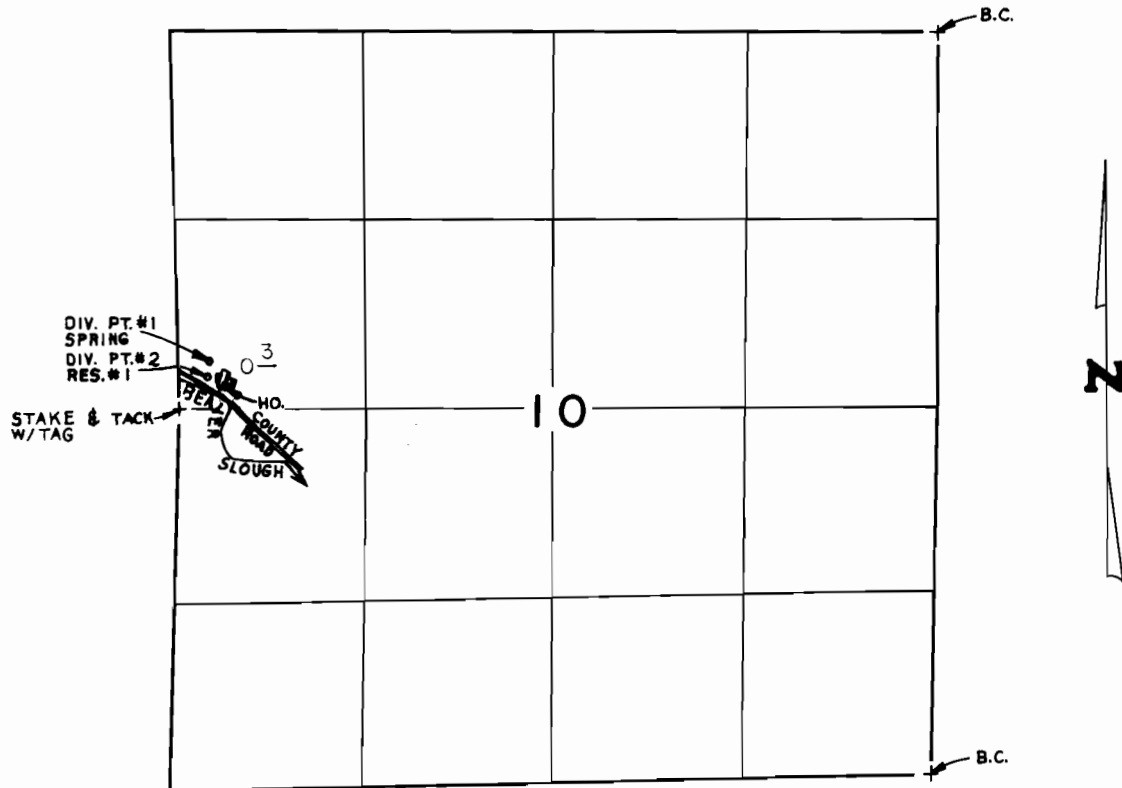

DIV. PT. #1, SPRING LOCATED 340' N. & 205' E. FROM W. 1/4 COR. SEC. 10  
DIV. PT. #2, RES. #1 LOCATED 240' N. & 195' E. FROM W. 1/4 COR. SEC. 10

SCALE: 4" = 1 mile

**FINAL PROOF SURVEY**  
UNDER

Application No. 52724... Permit No. 39833.....  
IN NAME OF

.....BILLIE W. WHEELER.....

Surveyed OCT. 19, 1983, by L. CASHION....