


T. 27S., R. 12W., W.M.

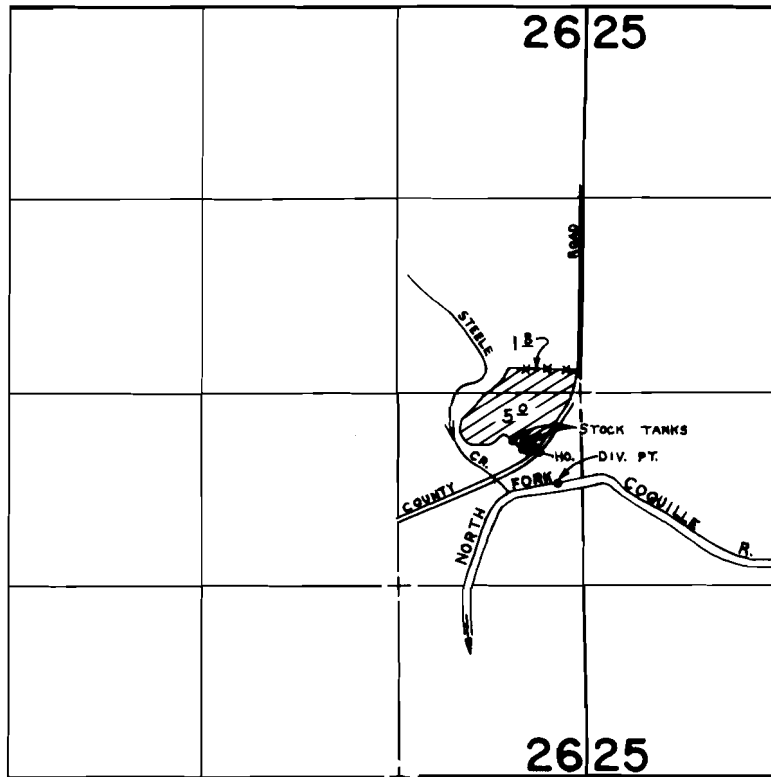

DIV. PT. LOCATED 620'S. & 160'W. FROM E. 1/4 CORNER SECTION 26

SCALE: 4" = 1 mile

FINAL PROOF SURVEY UNDER

Application No. 54325.. Permit No. 40672....
IN NAME OF

.....**CANDIS ANN WADE**.....

Surveyed OCT. 12., 1983, by L. CASHION.....