


T. 27S., R. 13W., W.M.

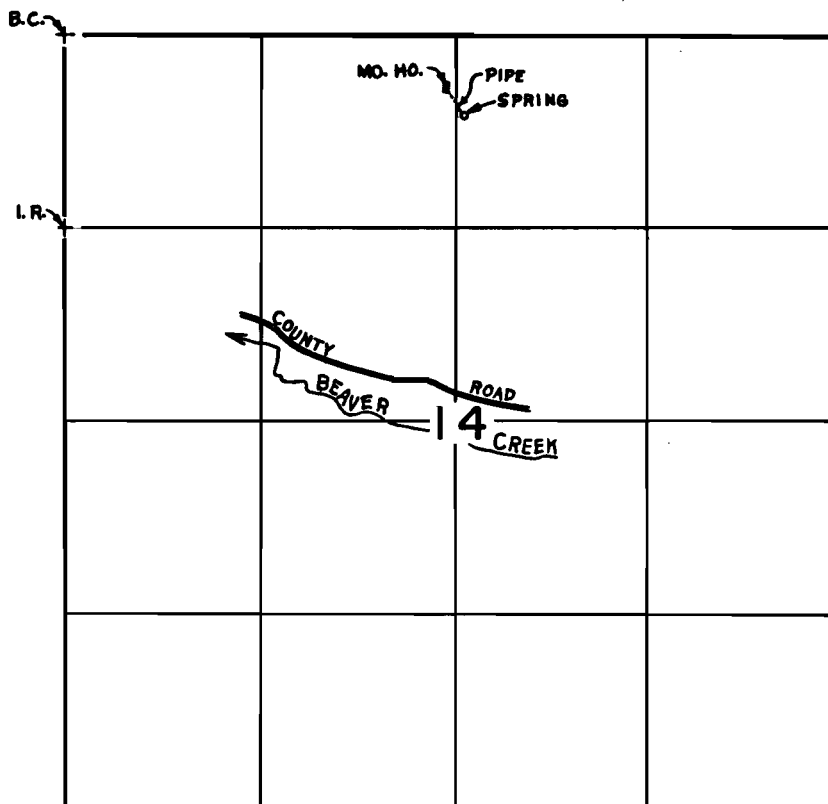

SPRING LOCATED 545' S. & 55' E. FROM N. 1/4 COR. SEC. 14

SCALE: 4" = 1 mile

FINAL PROOF SURVEY
UNDER

Application No. 61296.. Permit No. 45619.....
IN NAME OF

.....ROGER E. DUNITHAN.....

Surveyed OCT. 19, 1983., by L. CASHION...