


T. 28 S., R. 12 W., W. M.

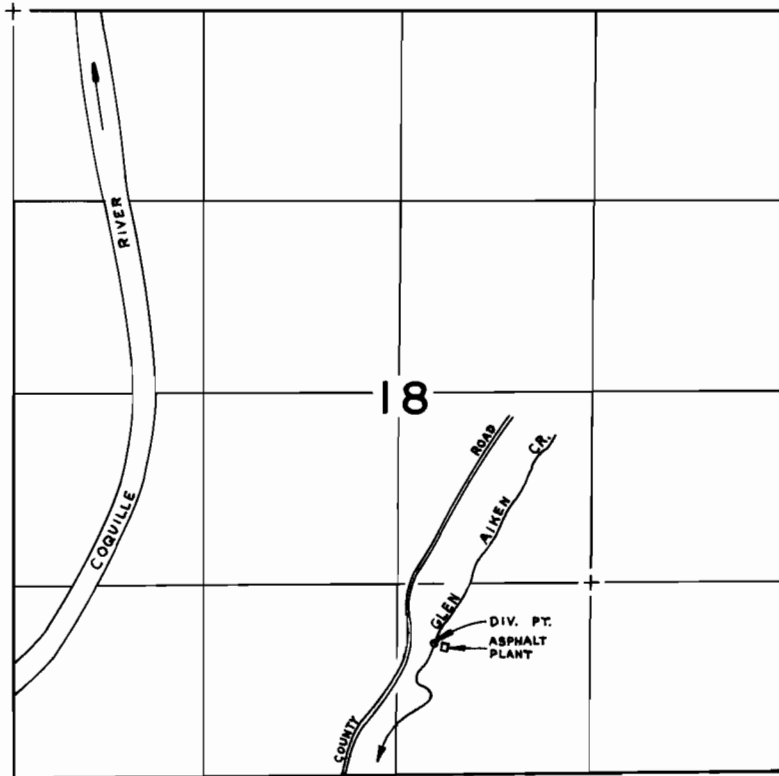

DIV. PT. LOCATED 915' N. & 255' E. FROM S. 1/4 CORNER SECTION 18

SCALE: 4" = 1 mile

FINAL PROOF SURVEY
UNDER

Application No. 61340... Permit No. 45667.....
IN NAME OF

COOS COUNTY HIGHWAY DEPT.

Surveyed OCT. 12, 1983, by L. CASHION