


T. 28 S., R. 14 W., W.M.

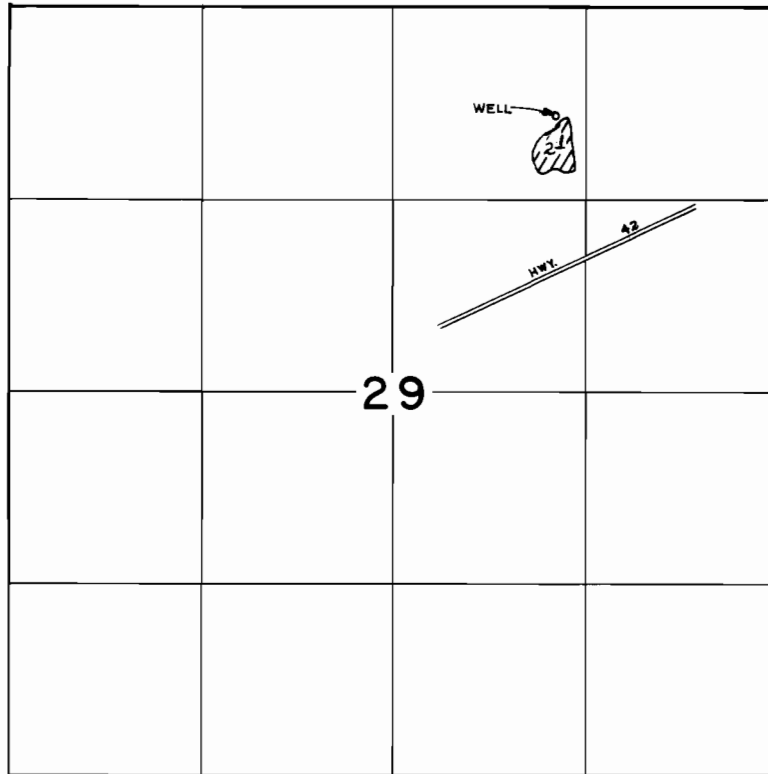

WELL LOCATED 740'S. & 205'W FROM E. 1/16 CORNER SECTIONS 20 & 29

SCALE: 4" = 1 mile

FINAL PROOF SURVEY UNDER

Application No. G-7352. Permit No. G-6894.....
IN NAME OF

.....HENRY J. PHILIPPS.....

Surveyed NOV. 2, 1983, by L. CASHION....