


T.24S. R.5W. W.M.

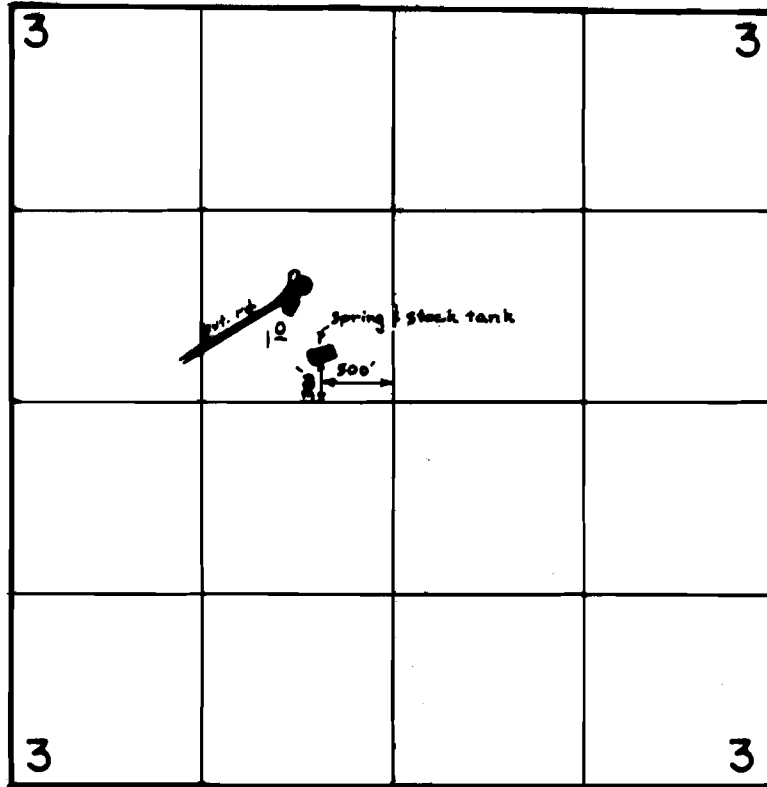

SCALE: 4" = 1 mile

FINAL PROOF SURVEY
UNDER

Application No. 56521 Permit No. 42449
IN NAME OF

KATHY JONES

Surveyed Aug. 2, 1979, by S. Donaldson