


T. 23 S., R. 7 W., W.M.

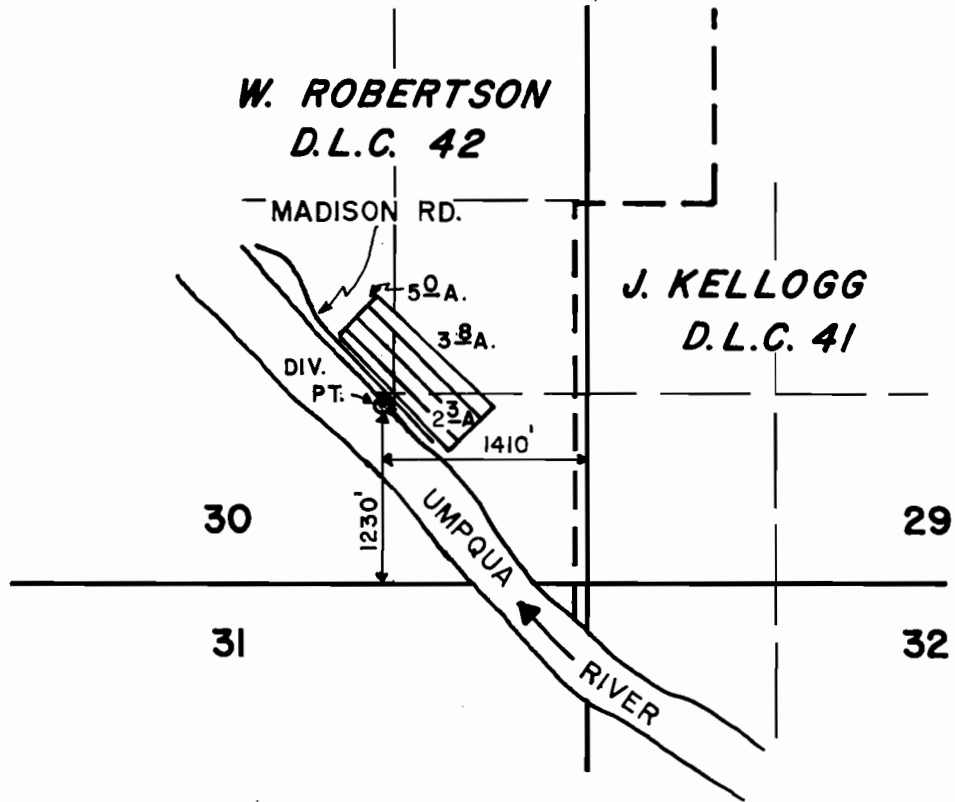

SCALE: 1" = 1320'

FINAL PROOF SURVEY UNDER

Application No. 60320... Permit No. 45156.....
IN NAME OF

KENNETH O. MADISON

Surveyed AUG. 26, 1986, by J.M. SCHMORDE