


T. 29 S., R. 6 W., W.M.

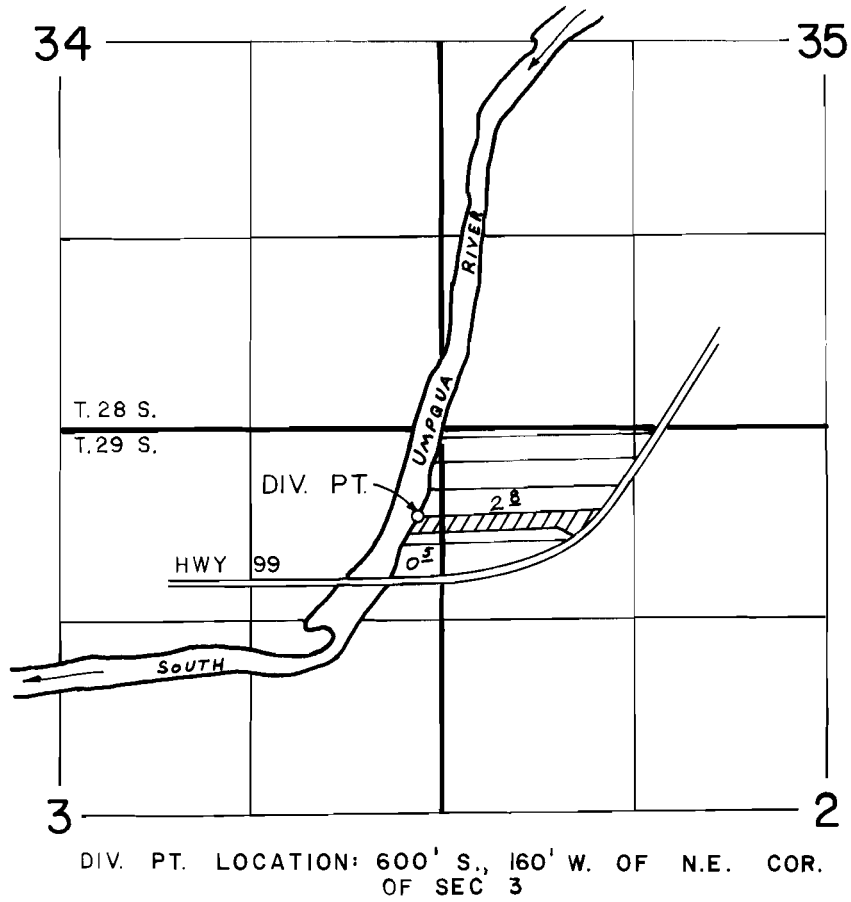

SCALE: 4" = 1 mile

FINAL PROOF SURVEY
UNDER

Application No. 63207 Permit No. 46696.....
IN NAME OF

.....**LORI BROWN**.....

Surveyed DEC. 13, 1983, by *J. E. Cashion*