


P-37694
C-SS866

T.14S., R.31E., W.M.

SECTION 11

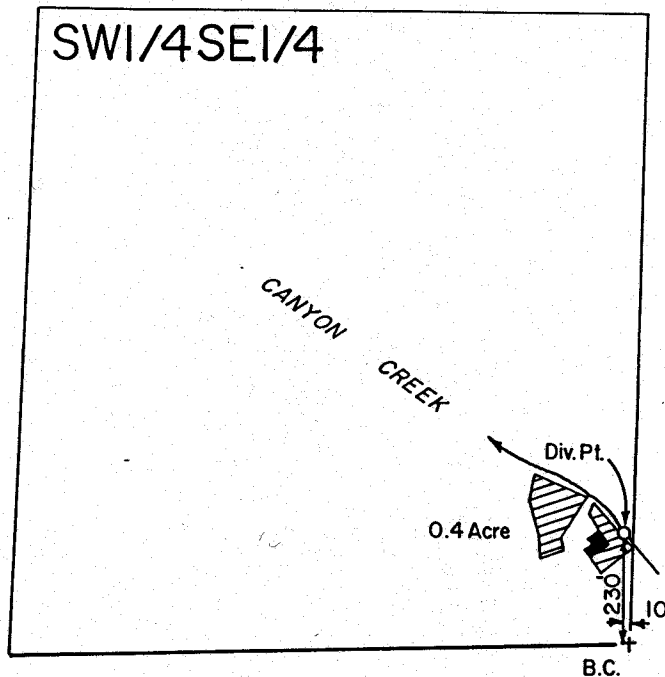

SCALE 1" = 400'

FINAL PROOF SURVEY UNDER

Application No. 50190 Permit No. 37694
IN NAME OF

HOLLY PORTER

Surveyed OCT. 7., 1981. by *[Signature]*