


T-5886 is Adding additional
(V.41, p. 19)

P.O.D for 27⁰ in NE SE Sec 25

T.2N., R.10E., W.M.

Additional P.O.D. is EFID
P.O.D.

LMT
W43

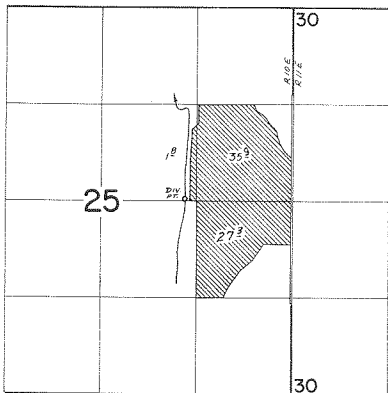

27⁰ acres was
part of C. 43959
(priority 1871).

DIV. P.O. LOC: 30' N $\frac{1}{2}$ 160' W FROM SE COR. SW $\frac{1}{4}$ NE $\frac{1}{4}$ SEC. 25

FINAL PROOF SURVEY
UNDER

Transfer No. T-65

Application No. Permit No.

IN NAME OF

TALLMAN ORCHARDS

Surveyed April 15 1975, by D. Norby