


T.32S., R.1W., W.M.

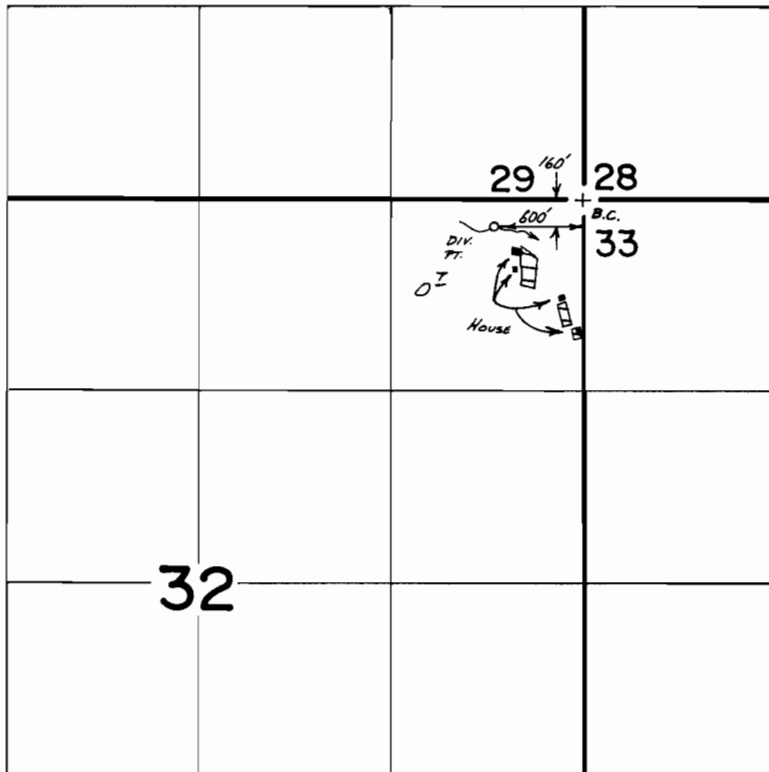

Scale 1"=1320'

FINAL PROOF SURVEY UNDER

Application No. 50367 Permit No. 38020
IN NAME OF

WILLIAM MARTIN

Surveyed Oct. 15 1985, by B.S. JAMES