


T. 40S., R. 4E., W.M.

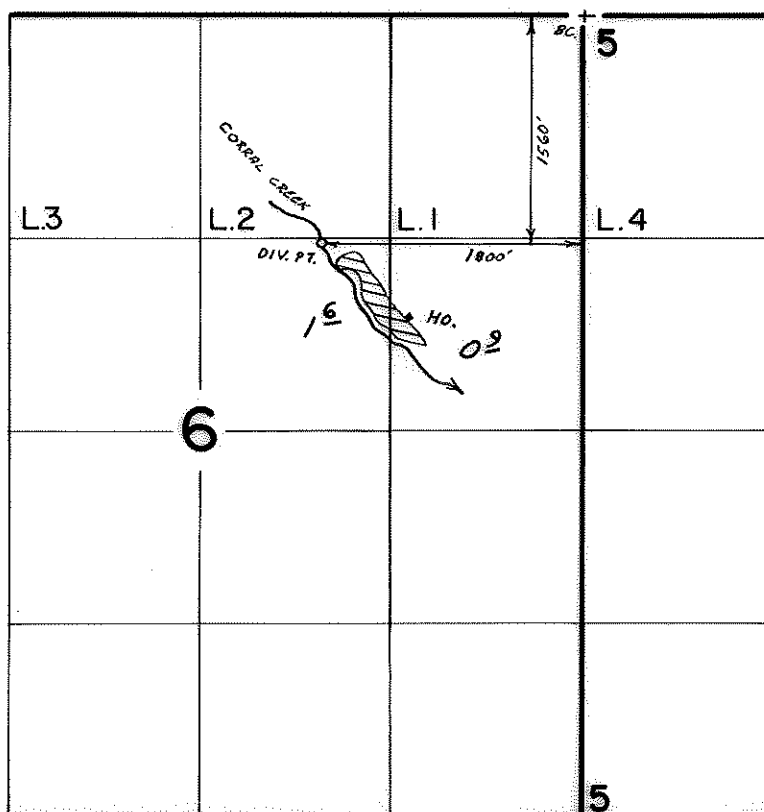

Scale 1" = 1320'

FINAL PROOF SURVEY
UNDER

Application No. 52,513... Permit No. 39807.....
IN NAME OF

LAWRANCE T. & or HARRIET J. SCHULTZ

Surveyed Aug. 16., 19.85, by B.S. JAMES.....