


0684

40393  
55876

T.40S., R.1E., W.M.

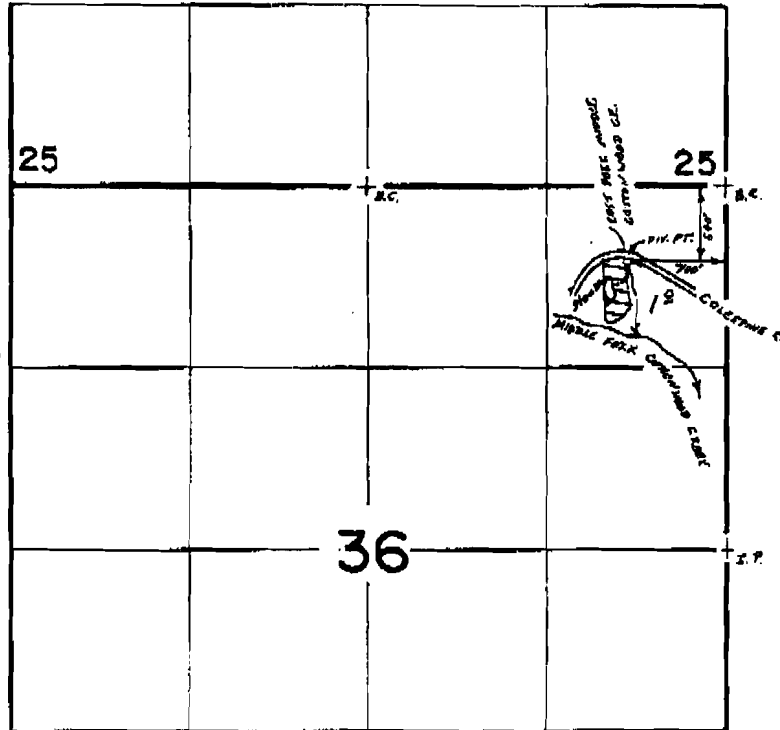

Scale 1"=1320'

# FINAL PROOF SURVEY UNDER

Application No. 53867.. Permit No. 40393.....  
IN NAME OF

...FRANCIS...H...&...DONNA...TREON.....

Surveyed Sept..12... 19.55, by BS. JAMES.....

4039-179-1346