


T. 35 S., R. 3 W., W.M.

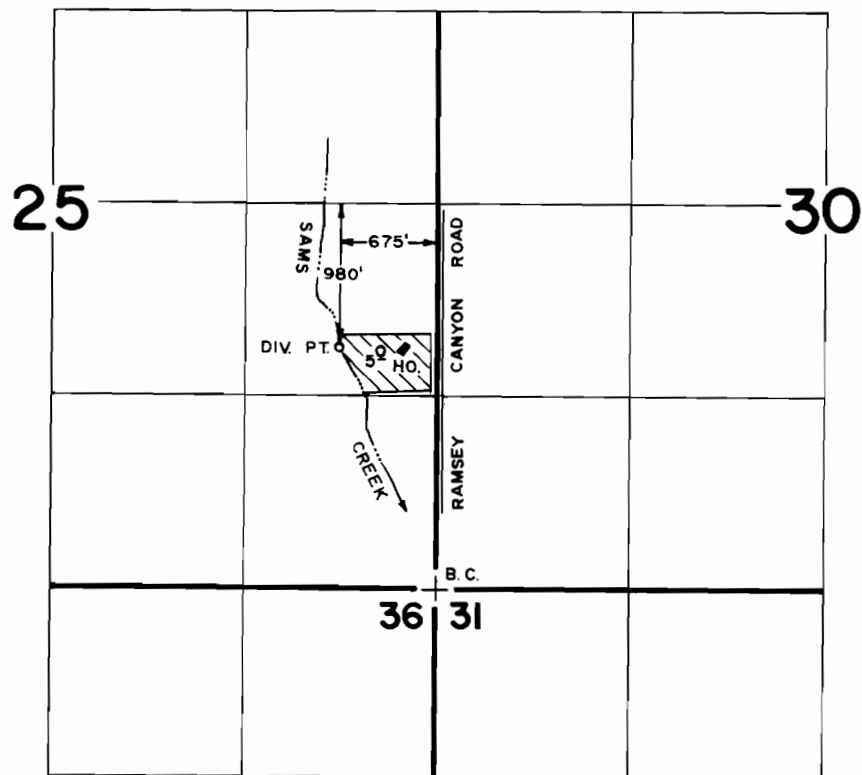

FINAL PROOF SURVEY
UNDER

Application No. **54890** Permit No. **41167**
IN NAME OF

GEORGE H. KELLEWAY

Surveyed **JULY 9** 19**82**, by **B. SUZIE JAMES**

SCALE: 4" = 1 MILE