


T. 36 S., R. 2 E., W.M.

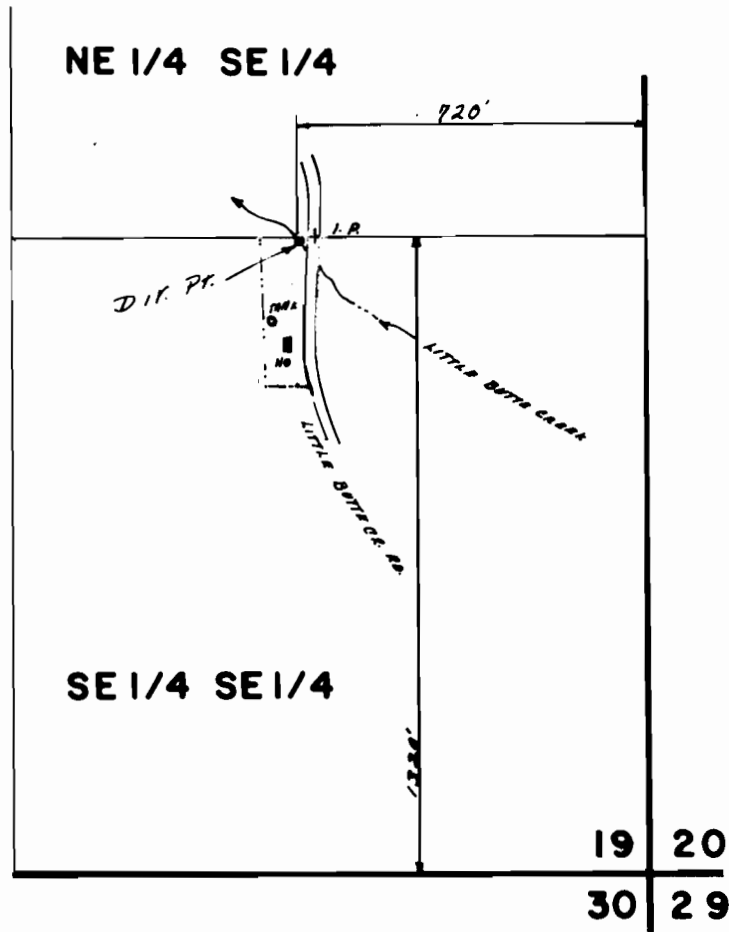

SCALE: 1" = 400'

FINAL PROOF SURVEY
UNDER

Application No. **55253** Permit No. **41473**
IN NAME OF

R.U.T.H. E. HUMPHREY

Surveyed O.C.T. 2, 1985, by B.S. JAMES.