


T. 35S., R. 4 W., W.M.

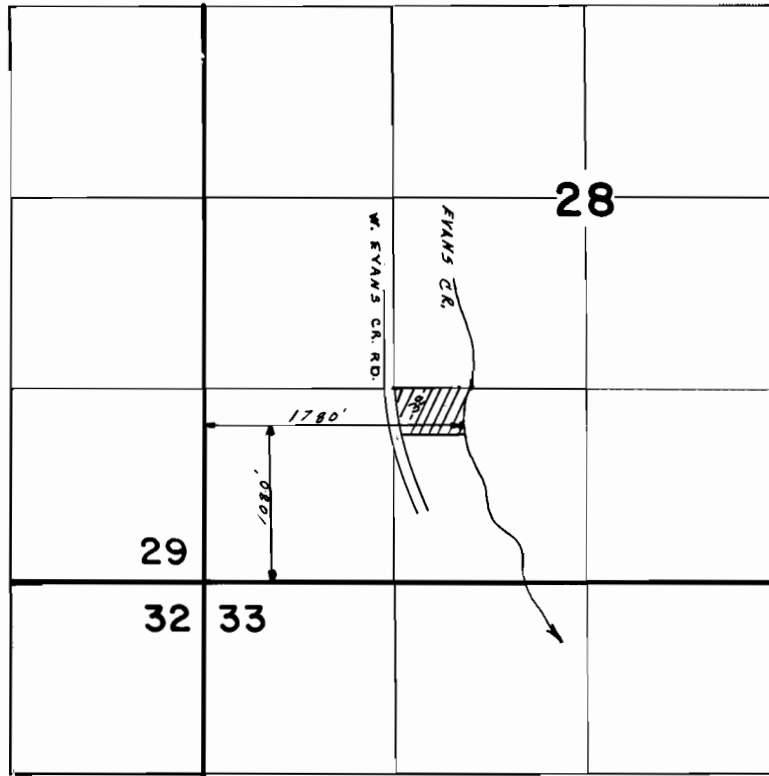

SCALE: 1" = 1320'

FINAL PROOF SURVEY
UNDER

Application No. 56545. Permit No. 42435....
IN NAME OF

HOWARD A. JOHNSON

Surveyed AUG. 13. 1985, by B. S. JAMES.