


T. 39S., R. 3W., W.M.

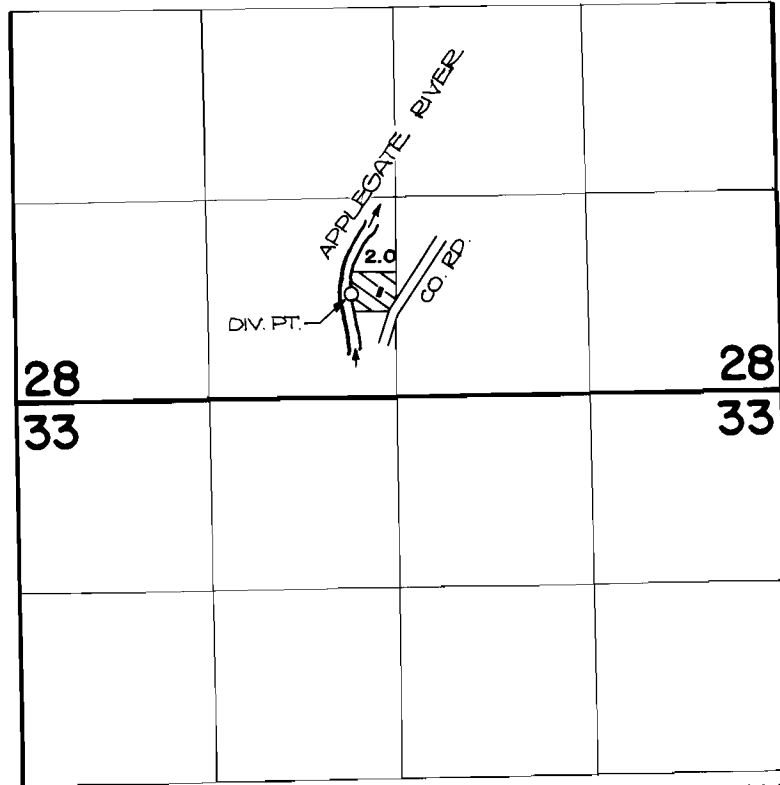

THE DIVERSION POINT IS LOCATED 600' N. AND 310' W FROM THE S. 1/4 CORNER OF SECTION 28.

FINAL PROOF SURVEY UNDER

Application No. ~~57489~~ Permit No. ~~43265~~.....
IN NAME OF

JOHN AND/OR JOANNE T. RETZLAFF

Surveyed JULY 14, 1983, by B. JAMES.....