


T. 36 S., R. 4 W., W.M.

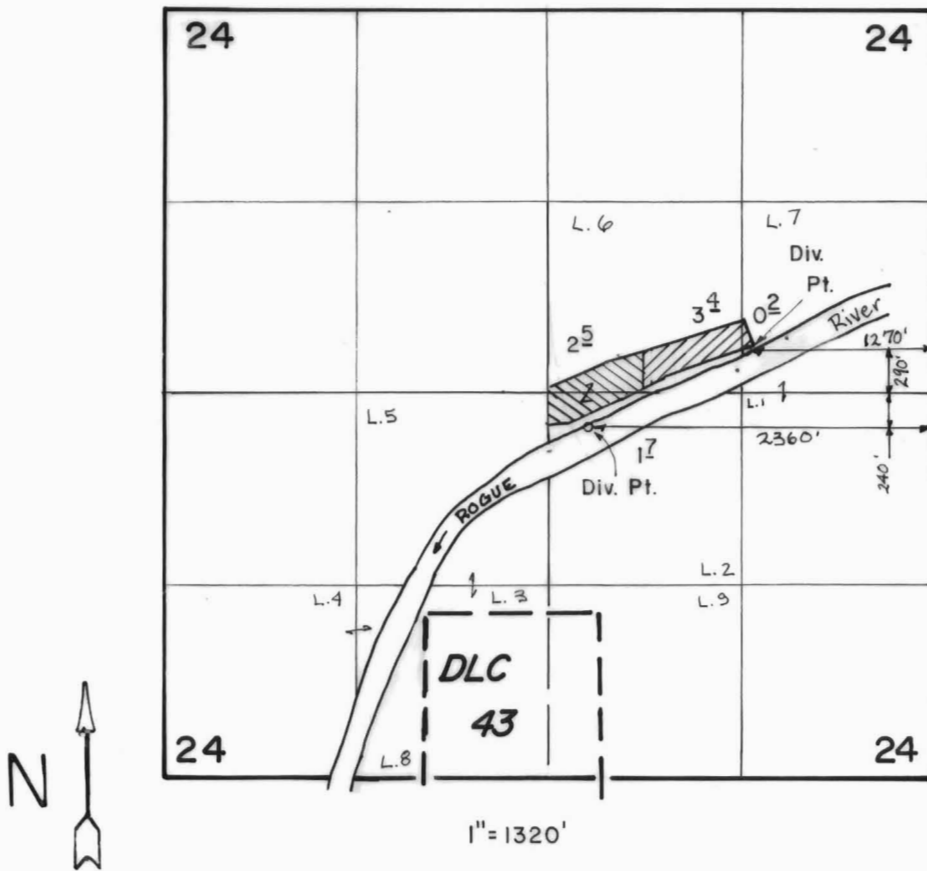

FINAL PROOF SURVEY UNDER

Application No. 60146 45129 Permit No. 58330 43942
 IN NAME OF

SCOTT M. McCOLLUM

Surveyed JULY 30, 1982, by B. S. JAMES