


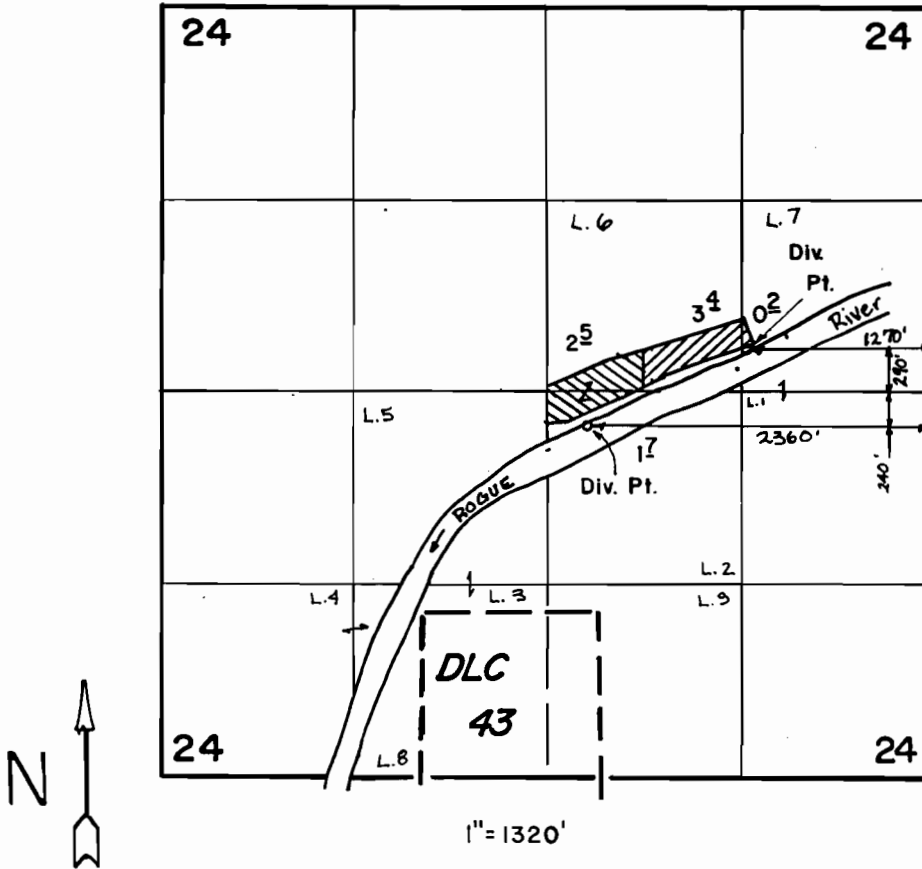

T.36 S., R.4 W., W.M.



FINAL PROOF SURVEY UNDER

60146 45129 
 Application No. 58330... Permit No. 43942... 

IN NAME OF

SCOTT M. McCOLLUM

Surveyed JULY 30, 1982, by B.S. JAMES.....