



T.33S., R.2E., W.M.

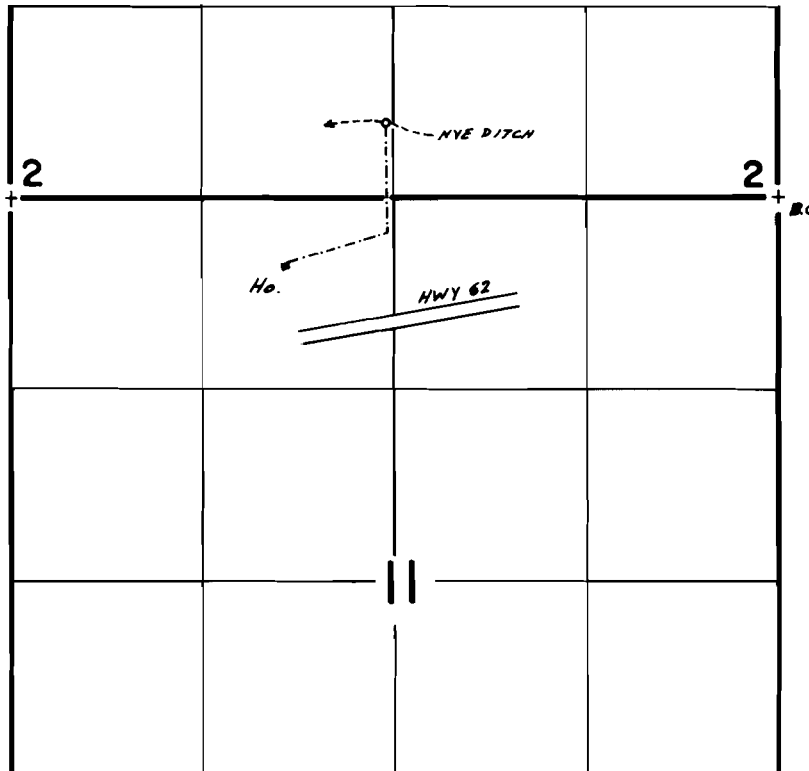

T.32S., R.3E.
Sec. 29

Scale 1"=1320'

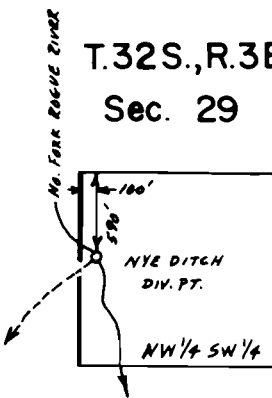

FINAL PROOF SURVEY
UNDER

Application No. 58462. Permit No. 44063....
IN NAME OF

RICHARD K. & or DIANA S. BEAN

Surveyed Oct. 28, 1985, by B.S. JAMES.....