


T.33 S., R.2 E., W.M.

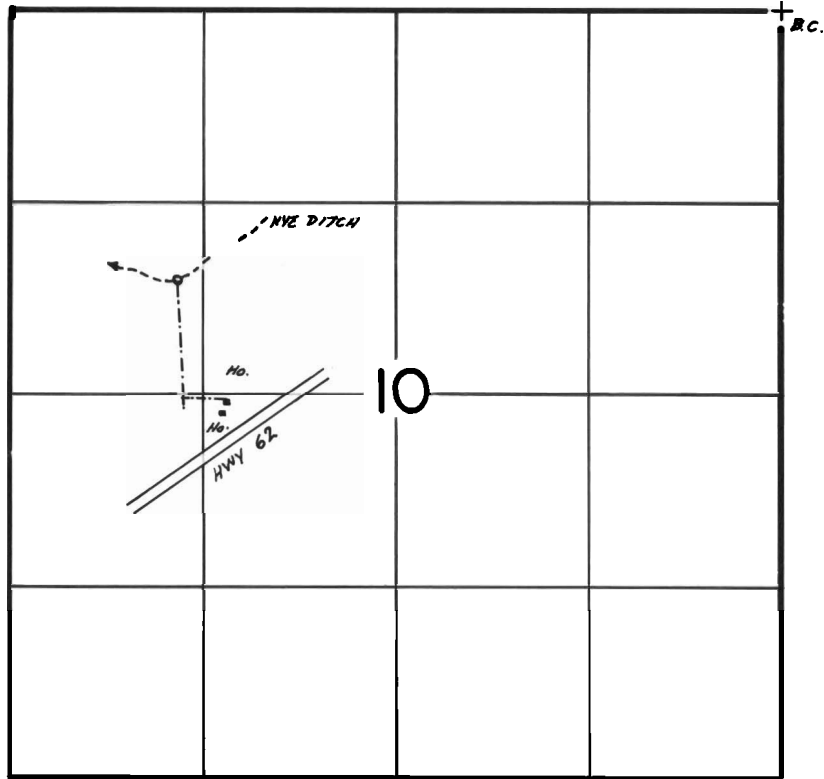


NO. FORK ROGUE RIVER

T. 32 S., R. 3 E.

Sec. 29

Scale 1"=1320'

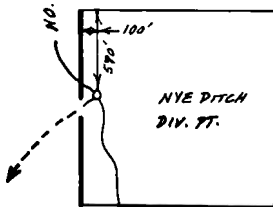

NW 1/4 SW 1/4

FINAL PROOF SURVEY

UNDER

Application No. 58463.. Permit No. 46162.....
IN NAME OF

LELA A. BEAN

Surveyed Oct...16... 1985., by B.S. JAMES.....

by