


# T. 35 S., R. 3 W., W.M.

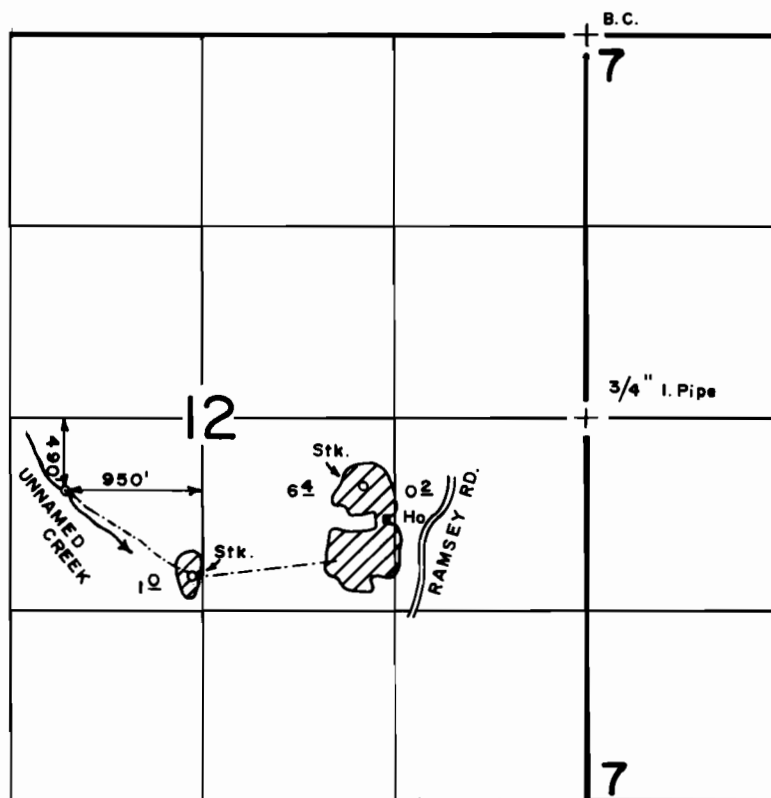

## FINAL PROOF SURVEY UNDER

Application No. ~~60266~~ Permit No. 45924.....  
IN NAME OF

.....JAMES A. ROBINSON.....

Surveyed JULY 22, 1982, by B.S. JAMES.....

Scale: 4" = 1 Mile