

Form No. 2286  
Application No. 29070  
Priority - March 10, 1954  
Find in Applegate River,  
Vol. 6

T. 38 S., R. 4 W., W.M.

~~cont 20883~~

C. 46556

**RECEIVED**

JUL 30 1981

WATER RESOURCES DEPT  
SALEM, OREGON


SCALE :  
8 INCHES = 1 MILE

Application No. 61990  
Permit No. 45941

23

Point of diversion located: 2510' S.  
and 3370' W. of NE corner of Long ~~EE~~  
DLC 39, being within the SE $\frac{1}{4}$  SW $\frac{1}{4}$  of  
Sec. 30, T. 38 S., R. 3 W., W.M.

~~KUBLI DITCH DIVERSION  
IS 1950'S & 1900' W. FROM  
N.E. COR SEC. 29, T. 38 S.,  
R. 3 W., W.M.~~

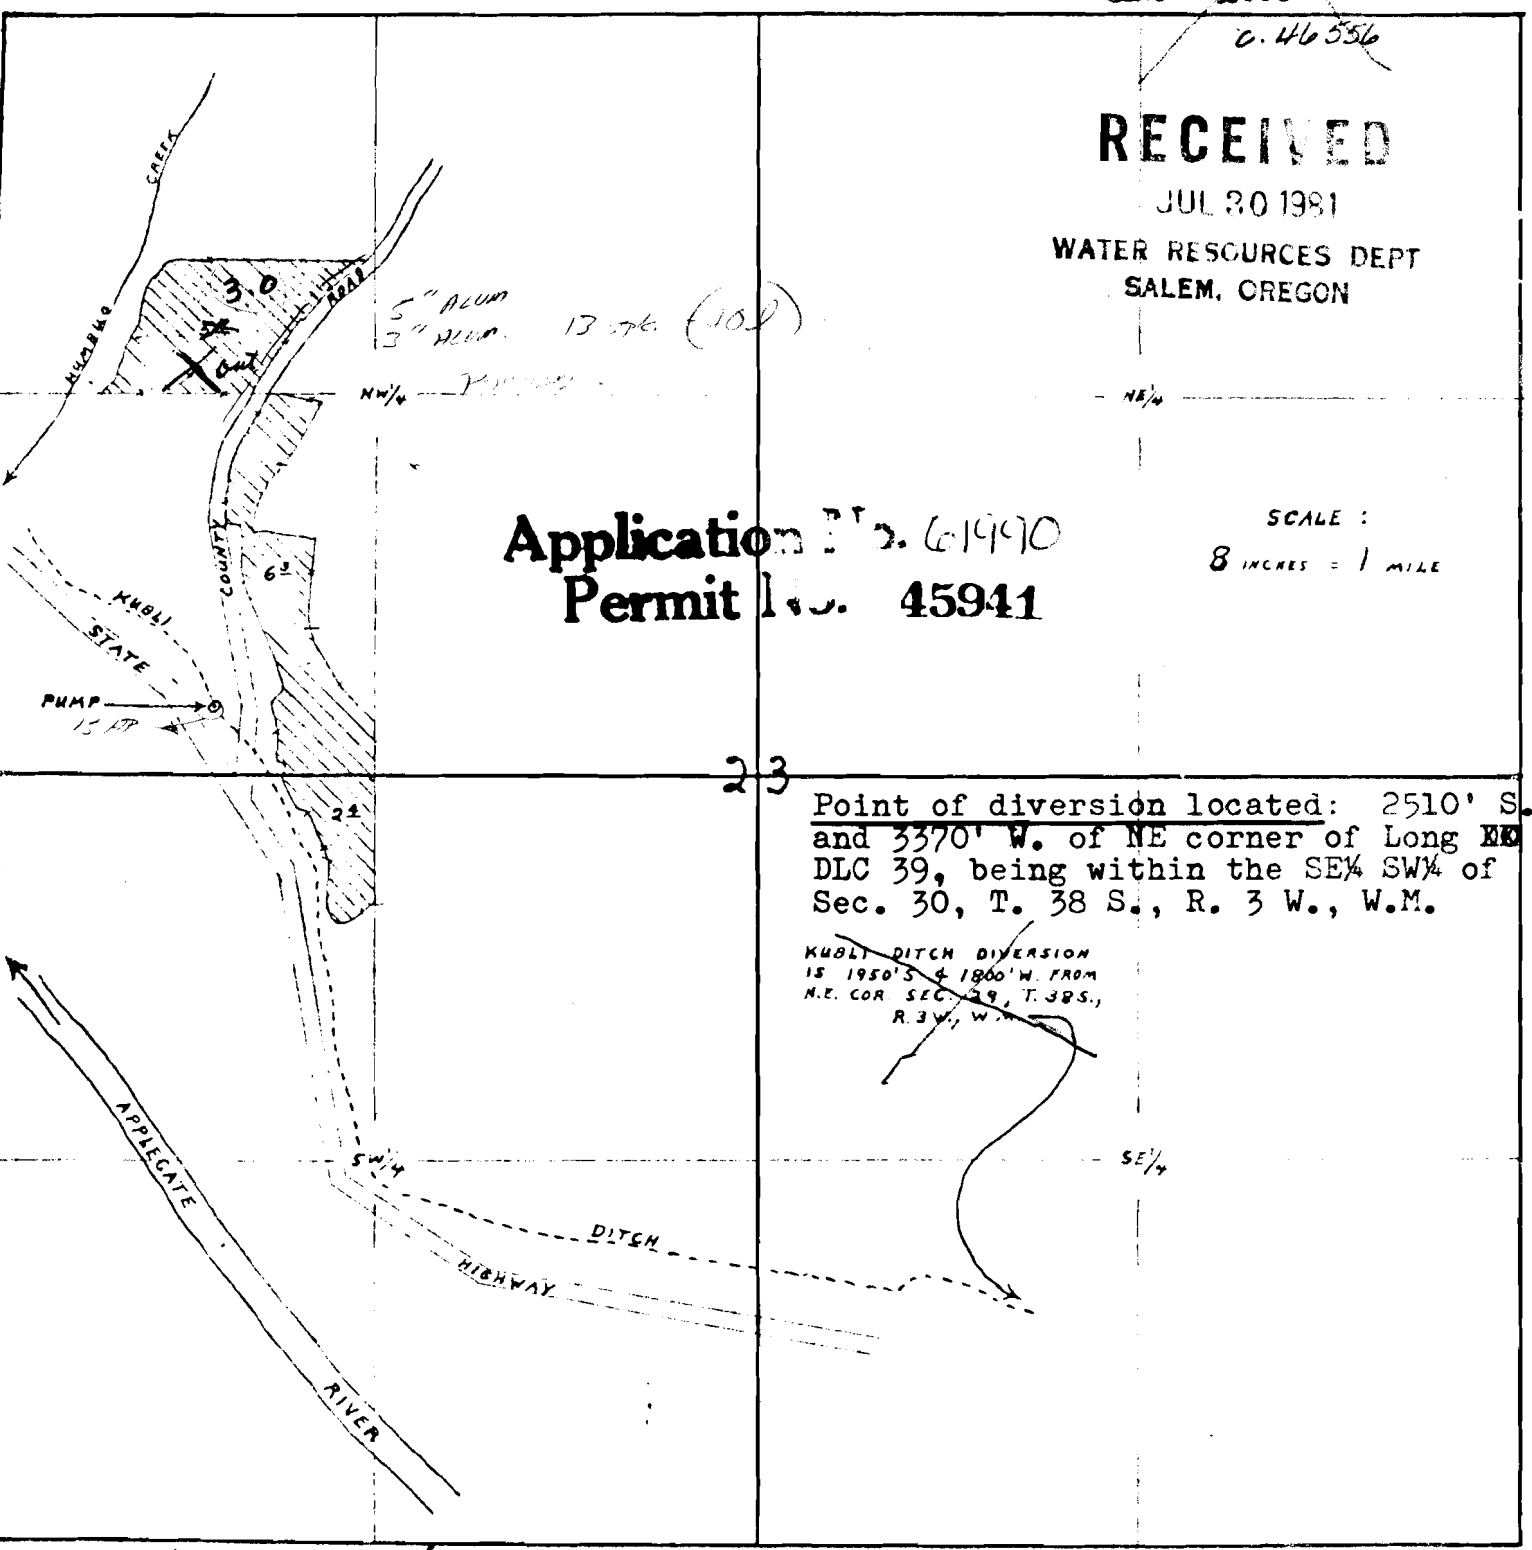

MAP ACCOMPANYING FINAL PROOF OF  
ARION D. CHRISTENSEN, FOR USE OF  
WATER FROM APPLIGATE RIVER THROUGH  
KUBLI DITCH FOR IRRIGATION AND  
SUPPLEMENTAL IRRIGATION PURPOSES.

MAP COPIED FROM PLANE TABLE  
SURVEY - MADE 12-9-54

David C. Hendrix  
WATERMASTER

Map to accompany application of C. J. Bernard  
to appropriate storage water from Applegate  
Lake Reservoir in APPLICATION No. 29070  
amount of 4 acre feet PERMIT No. 22863  
to supplementally irrigate  
above shaded in yellow area.