


Application No. 22968
Permit No. 18128
Priority March 30, 1948
Find in Applegate River,
Vol. 6
CERT. 20777

97 526

T. 38 S., R. 4 W., W.M.

Application No. 62020 Permit No. 45942

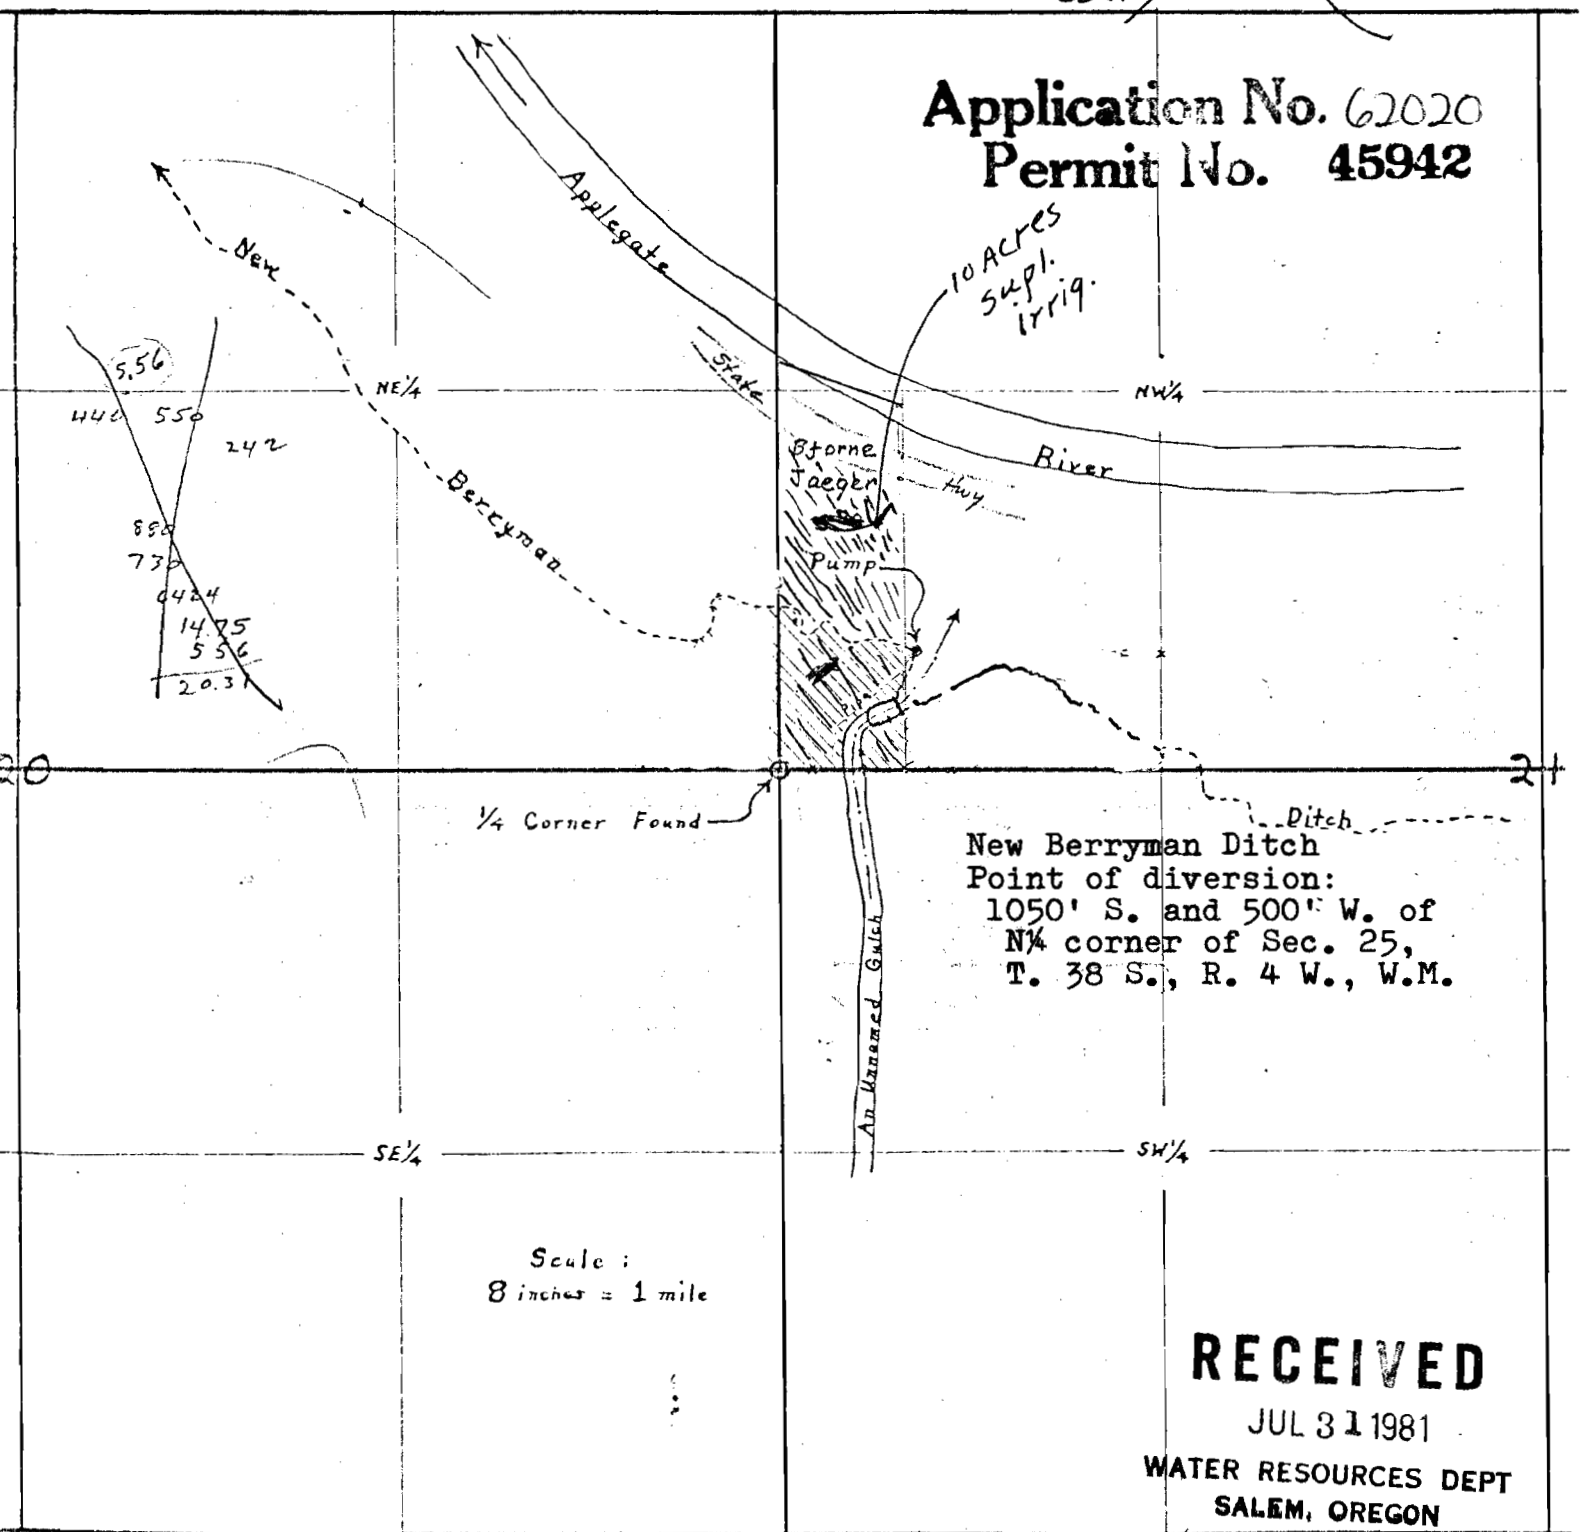

New Berryman Ditch
Point of diversion:
1050' S. and 500' W. of
NE 1/4 corner of Sec. 25,
T. 38 S., R. 4 W., W.M.

Scale:
8 inches = 1 mile

RECEIVED

JUL 31 1981

WATER RESOURCES DEPT
SALEM, OREGON

Map to accompany application of Bjorn J. Jaeger to appropriate water from storage of Applegate Lake Reservoir in amount of 10 acre feet to supplementally irrigate above shaded land.
Map accompanying final proof of C. G. Godlove, for use of water from Applegate River for irrigation purposes.

Application No. 22968

Permit No. 18128

February 18, 1955

David C. Hendrix, Watermaster Dist. No. 15