


E. W. Kubli  
Application No. 29301  
Permit No. 23331  
Priority - June 30, 1954  
Wind in Applegate River, Vol.

23

T. 38 S., R. 4 W., W.M.

#2 Pump ← C. Roloff

Scale: 8 inches = 1 mile

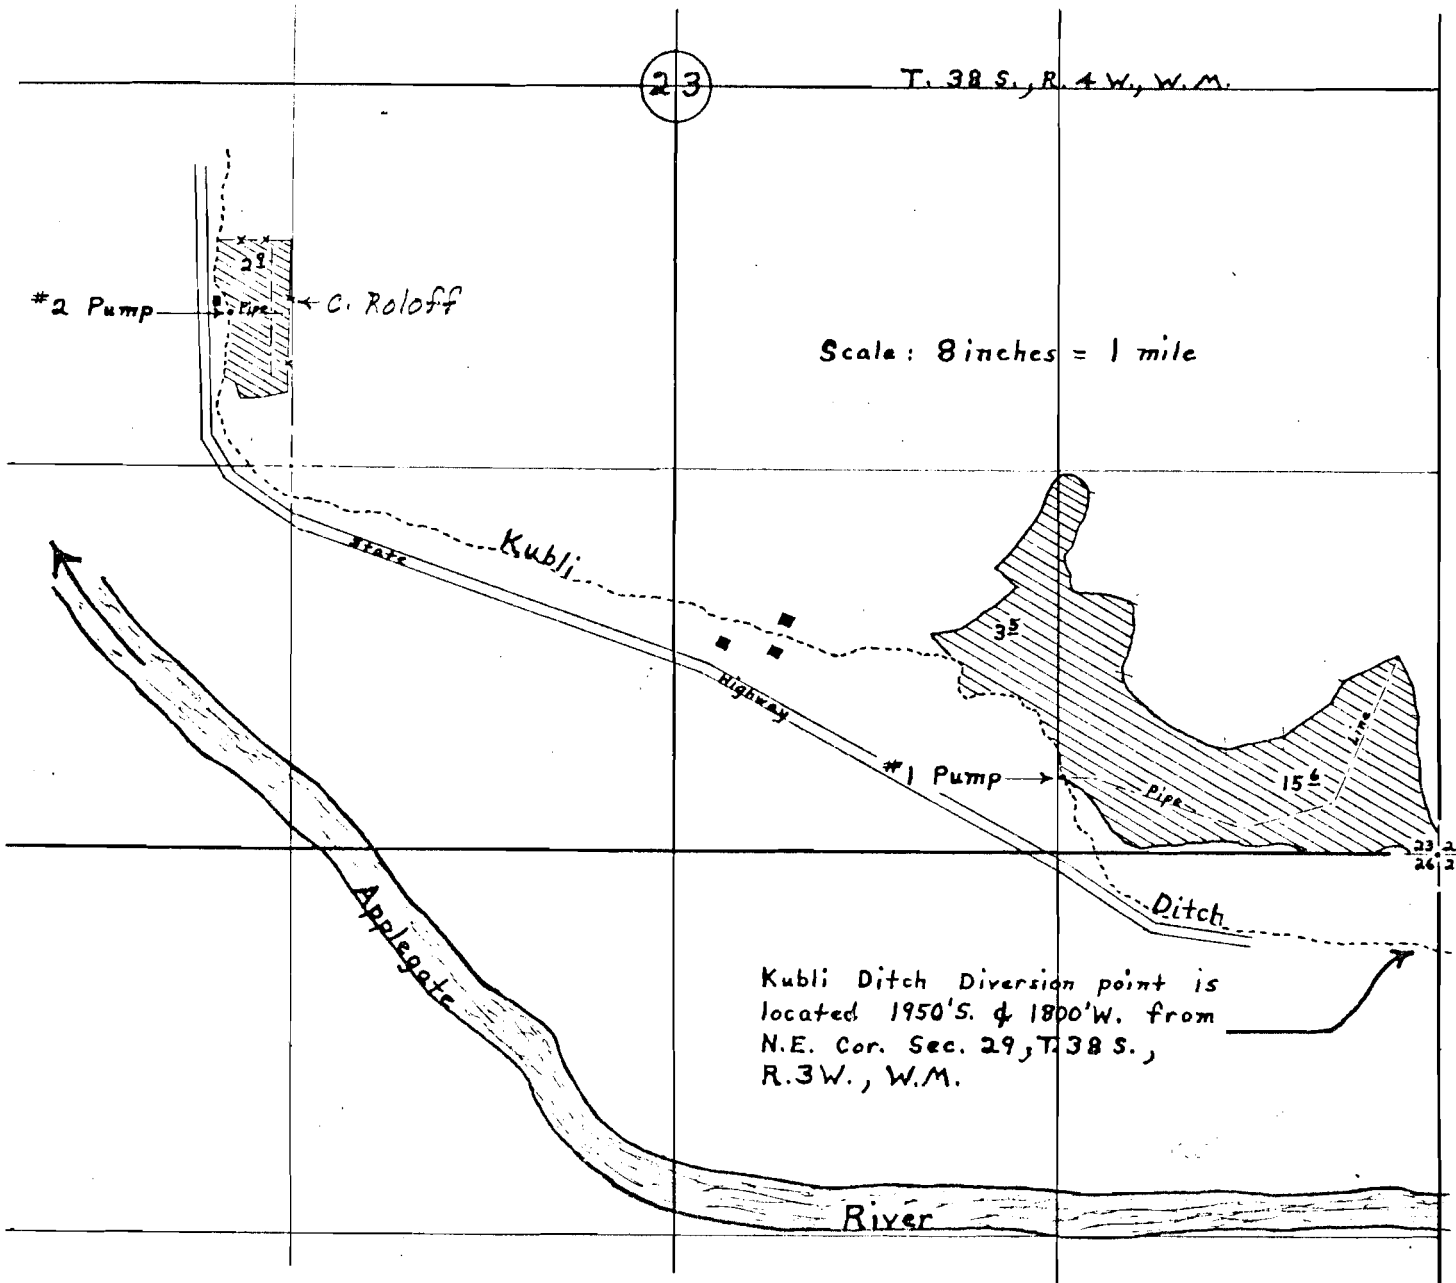

Kubli Ditch Diversion point is located 1950'S. & 1800'W. from N.E. Cor. Sec. 29, T.38 S., R.3W., W.M.

### FINAL PROOF SURVEY

UNDER

Application No. 29301 Permit No. 23331

IN NAME OF

E.W. Kubli

CERT. 21512

CERT. 46555

PRIORITY 6-30-54.

Surveyed March 29/30 1956, by David C. Hendrix