
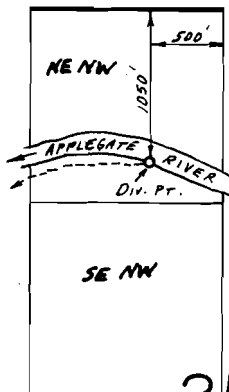


T.38S.,R.4W.,W.M.

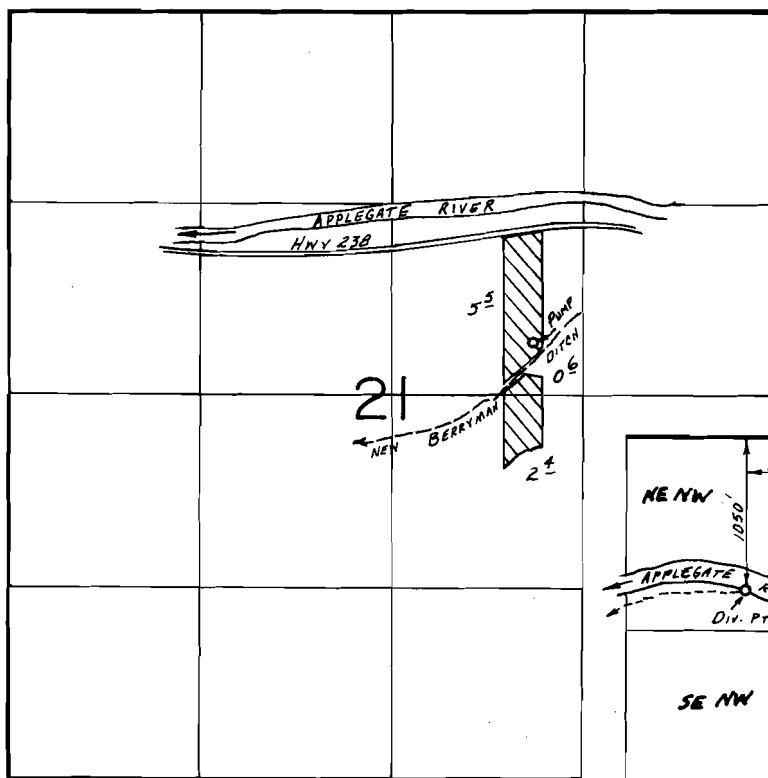

25

SCALE: 1"=1320'

FINAL PROOF SURVEY
UNDER

Application No. 62189... Permit No. 46029.....
IN NAME OF

CAROL D. & JOHN E. VANSYOC

Surveyed Aug. 8... 19.85, by B.S. JAMES.....

3/27/86
BdB

41029-179-117R