


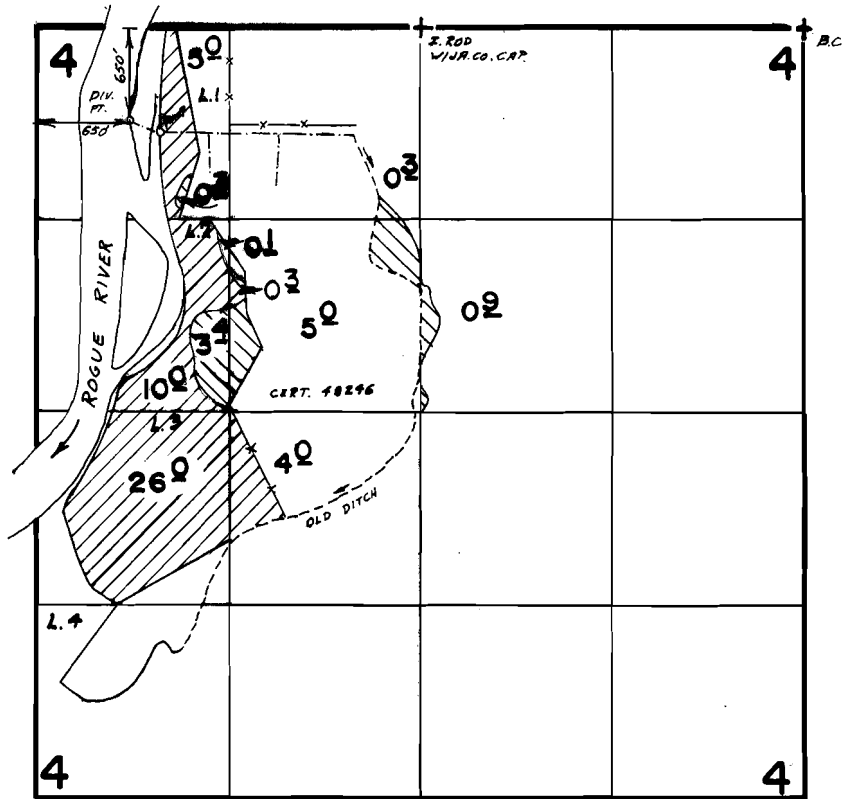

T. 35 S., R. 1 W., W.M.



Scale 1" = 1320'

FINAL PROOF SURVEY UNDER

-  PRIMARY
-  SUPPLEMENTAL

Application No. 61539.. Permit No. 47118.....
IN NAME OF

..EDWARD T. HARRISON, Jr.....

Surveyed Nov. 19.... 1985, by B.S. JAMES.....