


T. 38 S., R. 1 W., W. M.

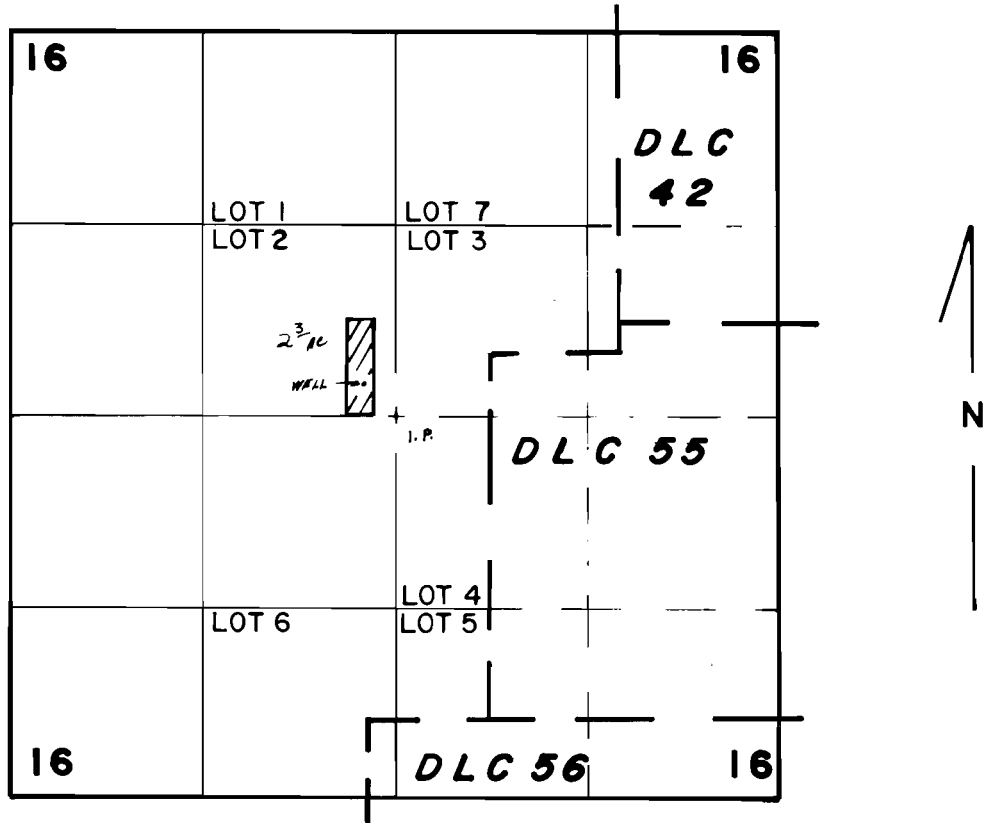

WELL: 220' N, 200' W. FROM CENTER CORNER OF SECTION 16

SCALE: 4" = 1 MILE

FINAL PROOF SURVEY UNDER

Application No. G-8220 Permit No. G-7660
IN NAME OF

L O N L . H O W A R D

Surveyed MAY 28 1985, by B. S. JAMES