


T. 35 S., R. 4 W., W.M.

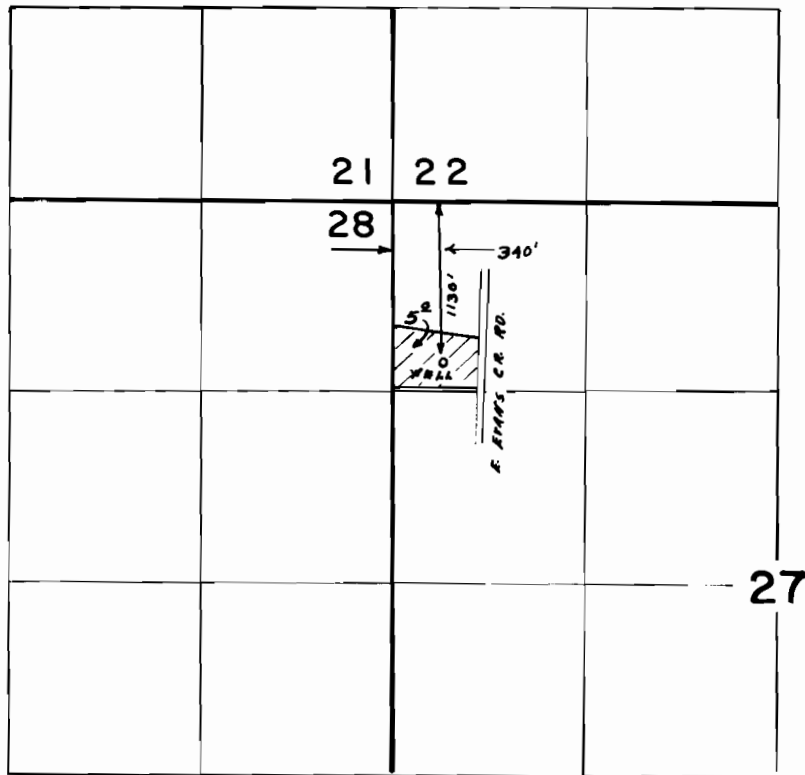

SCALE: 1" = 1320'

FINAL PROOF SURVEY
UNDER

Application No. G-10705 Permit No. G-9789
IN NAME OF

.....**ALAN TRESEMER**.....

Surveyed AUG. 15. 1985., by J. M. SCHMORDE