


T. 34 S., R. 5 W., W.M.

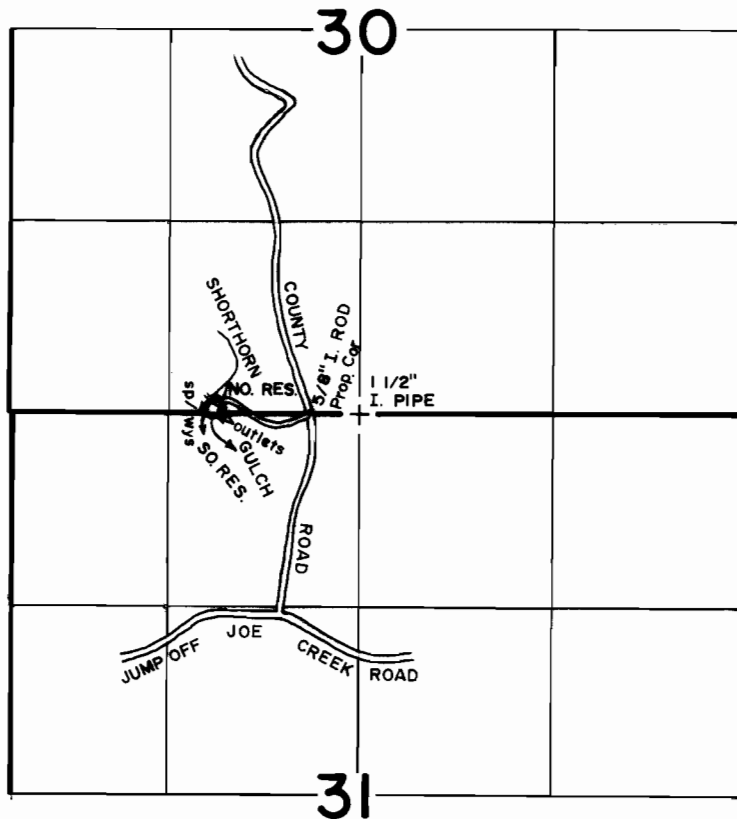

NO. RES. 100' N. & 975' W., from S. 1/4 COR. SEC. 30.

FINAL PROOF SURVEY
UNDER

Application No. **59818** **R-59830** Permit No. **45721** **R-8264**
IN NAME OF

EDWARD A. WHITE

Surveyed **NOV. 18** 19**82**, by **B. S. JAMES**

SCALE: 4"=1 MILE