


T.36S. R.7 W.W.M.

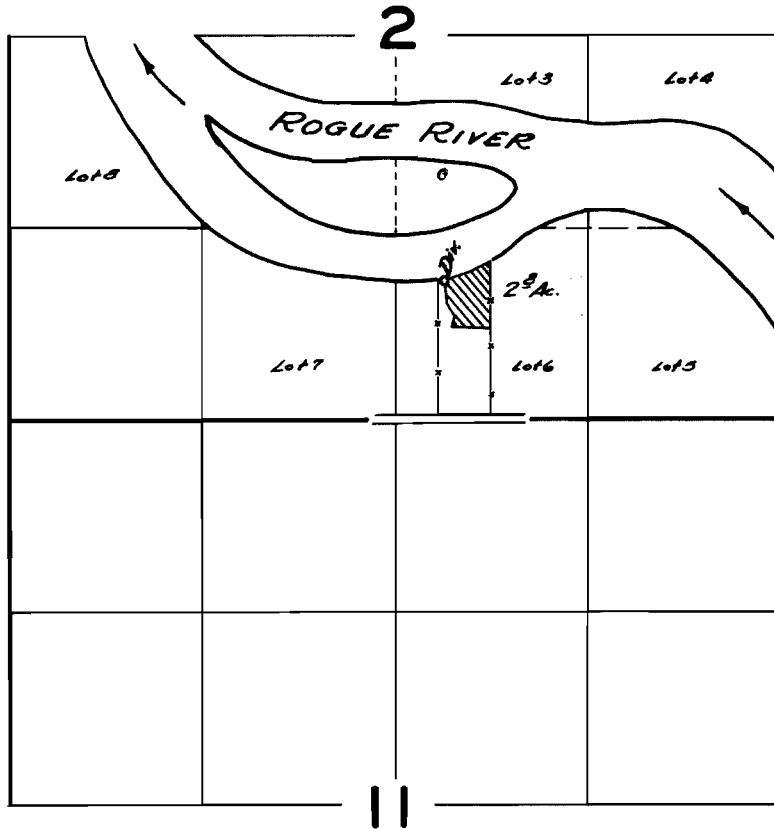

FINAL PROOF SURVEY
UNDER

Application No. 30794 Permit No. 24246
IN NAME OF

THOMAS J. MURPHY

Surveyed APRIL 13 1961, by COBARTO