


T. 37 S., R. 6 W., W.M.

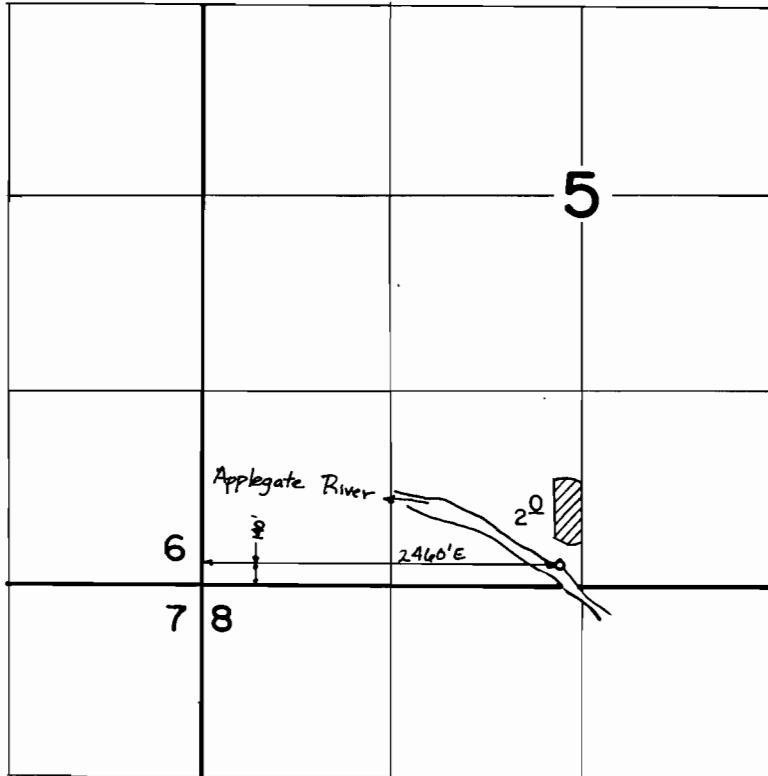

FINAL PROOF SURVEY UNDER

Application No. 56224.. Permit No. 42060.....
IN NAME OF

BILL & DONNA ROSE

Surveyed AUG. 10, 1982, by B. S. JAMES.....