


T. 36 S., R. 5 W., W.M.

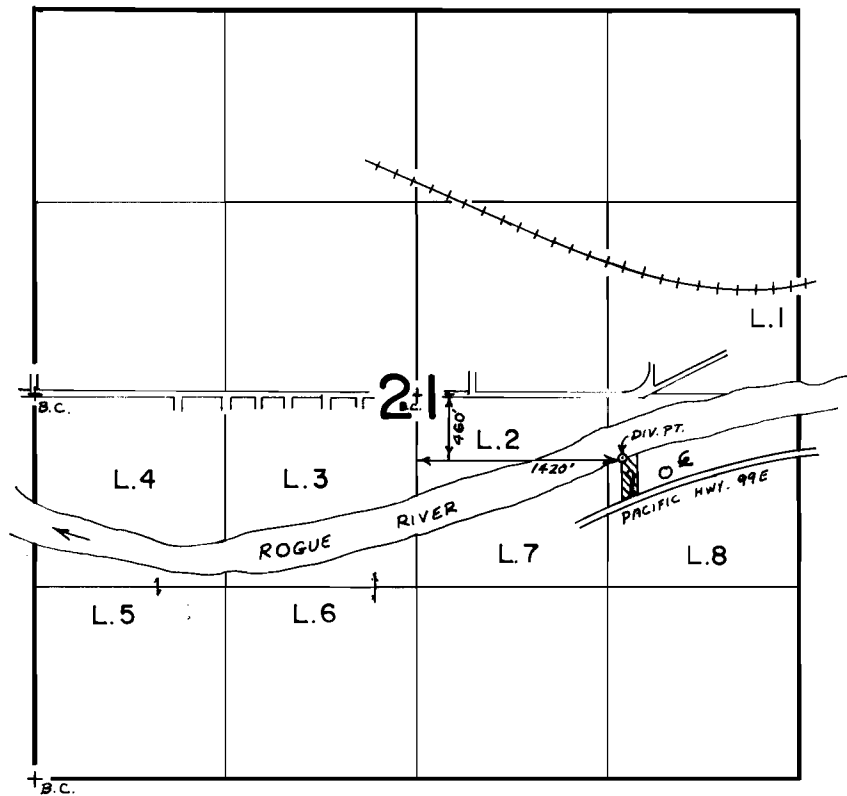

Scale : 4" = 1 mile

FINAL PROOF SURVEY
UNDER

Application No. 57516. Permit No. 43345....
IN NAME OF

.....HARRY G. McABEE.....

Surveyed Oct. 30, 1981, by Bruce R. Sund