


T. 36 S., R. 5 W., W. M.

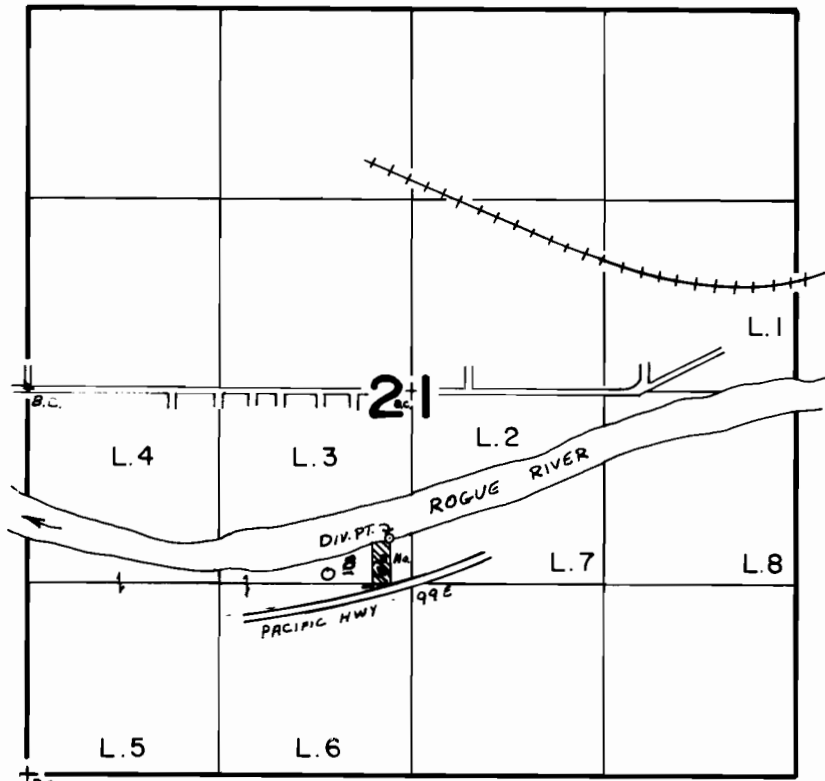

DIV. PT. : 1000' S & 140' W FROM CENTER 1/4 COR.

Scale 4" = 1 mile

FINAL PROOF SURVEY
UNDER

Application No. 57.786. Permit No. 434.75.....
IN NAME OF

.....RUBY V. SMITH.....

Surveyed Nov. 4, 1981., by Bruce R. Sund