


T.37S., R.5W., W.M.

(SECTION 35)

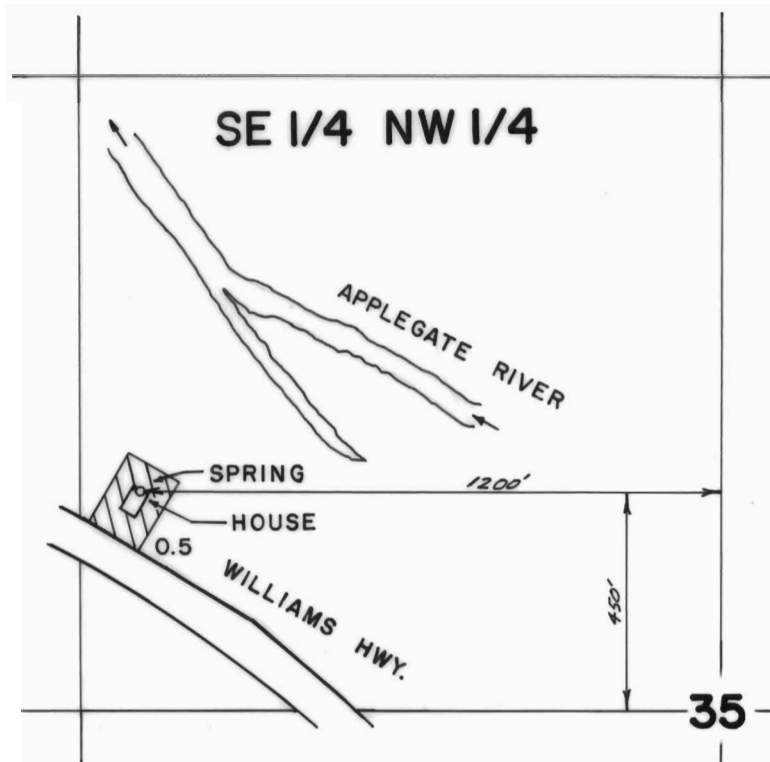

1" = 400'

FINAL PROOF SURVEY
UNDER

Application No. 58293 Permit No. 43977.....
IN NAME OF

ORVEL D. HARRIS.....

Surveyed APR 28 1982, by B. SUND.....