


T.37S., R.6W., W.M.

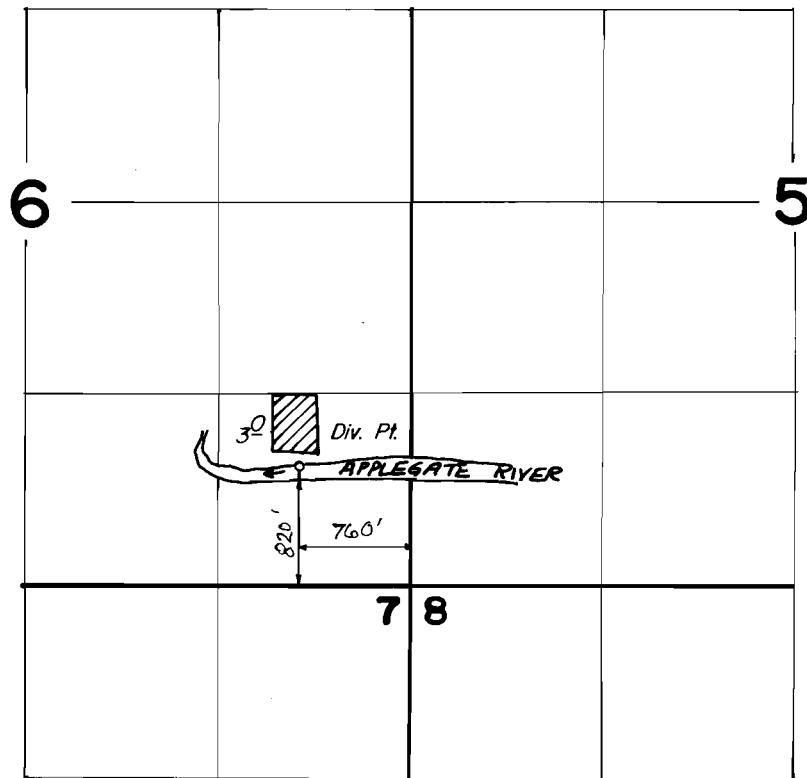

FINAL PROOF SURVEY
UNDER

Application No. 58708. Permit No. 44282....
IN NAME OF

DAVID C. RAVENCROFT

Surveyed Aug. 10, 1982., by B.S. JAMES.....