


T.37 S., R. 6 W., W.M.

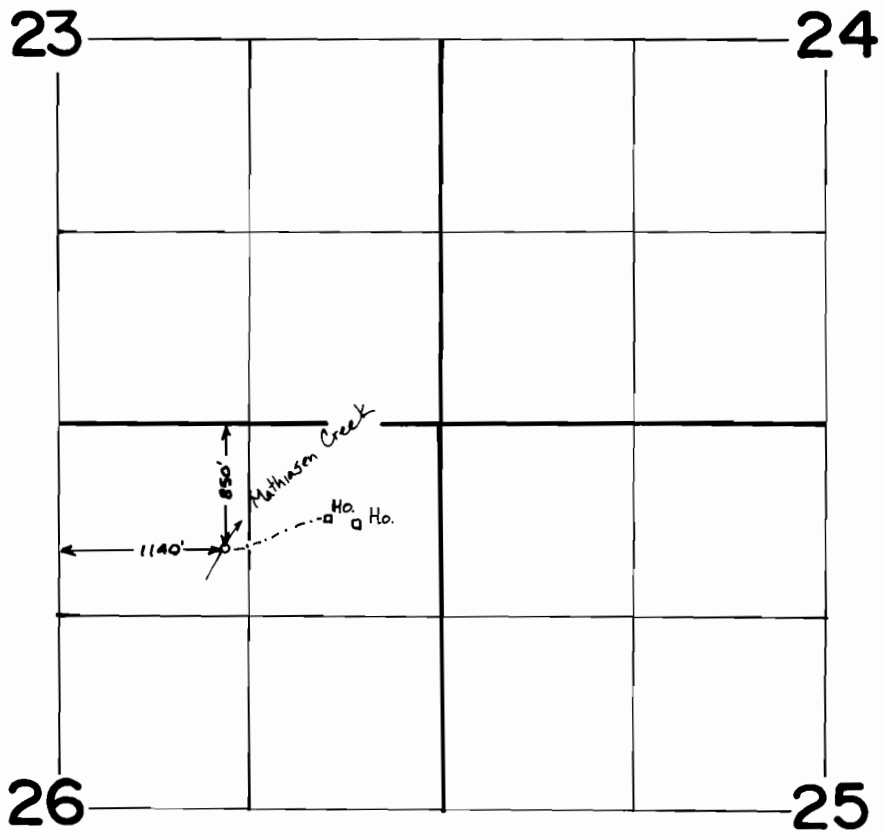

FINAL PROOF SURVEY
UNDER

Application No. 60276 Permit No. 45229
IN NAME OF

REX L. MATHIASSEN

Surveyed JUNE 16, 1982, by B. R. SUND