


T. 37 S., R. 5 W., W. M.

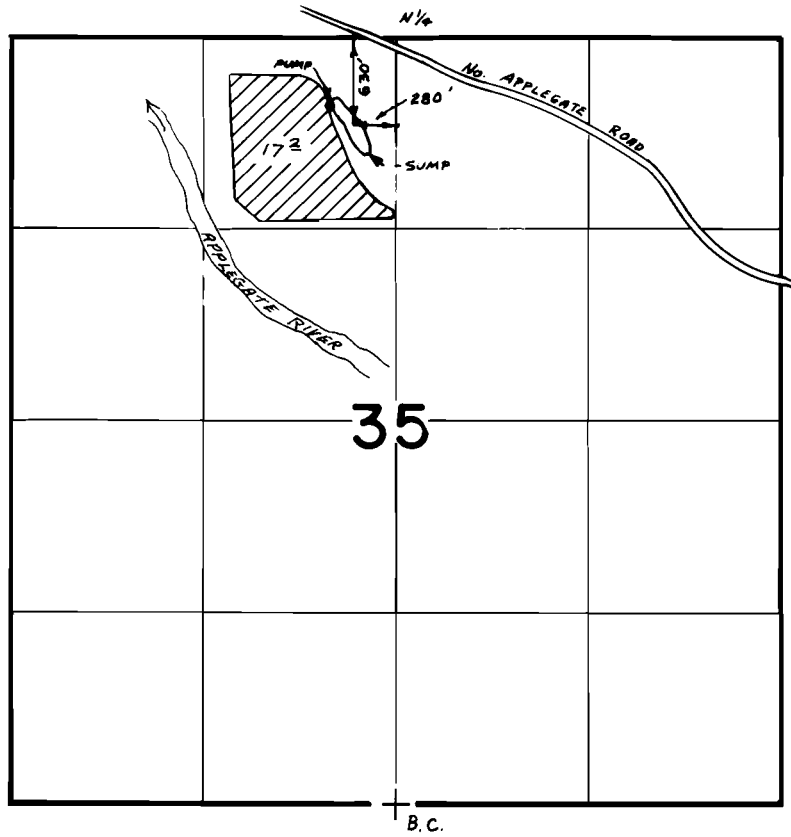

Scale : 4" = 1 Mile

FINAL PROOF SURVEY
UNDER

Application No. **G-3062** Permit No. **G-2855**.....
IN NAME OF

.....**JOHN McMAHON**.....

Surveyed **May 6** 19**82**, by **B. R. SUND**.....