


T. 38S., R. 5W., W.M.

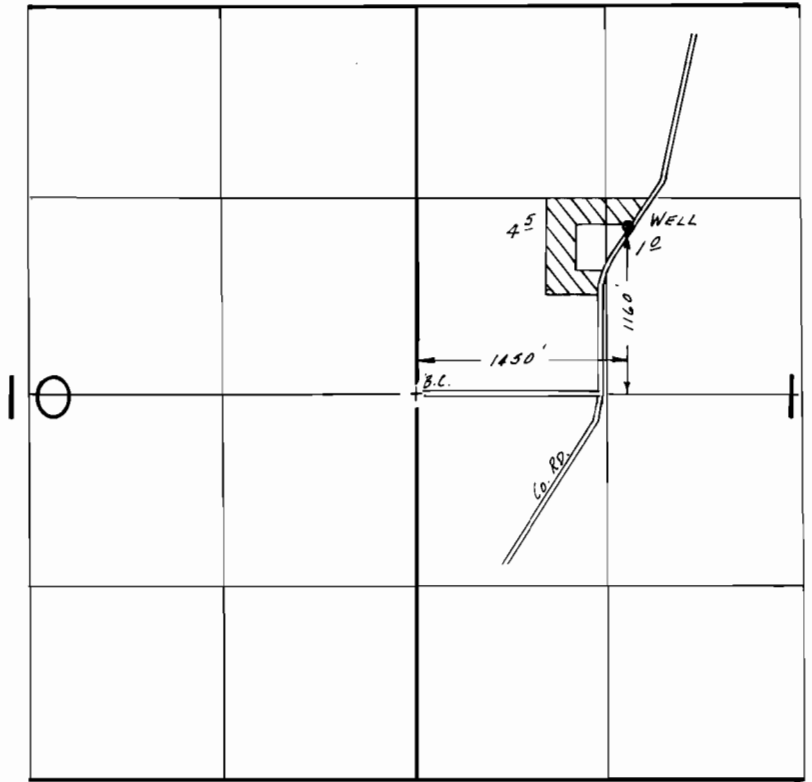

SCALE: 1" = 1320'

FINAL PROOF SURVEY
UNDER

Application No. G-9154. Permit No. G-8530.....
IN NAME OF

.....WILLIAM C. MACY.....

Surveyed Sept. 16.. 19.85., by B.S. JAMES.....

3/31/86
BWB
41033-179-109 L