


T. 35S., R. 6 W., W.M.

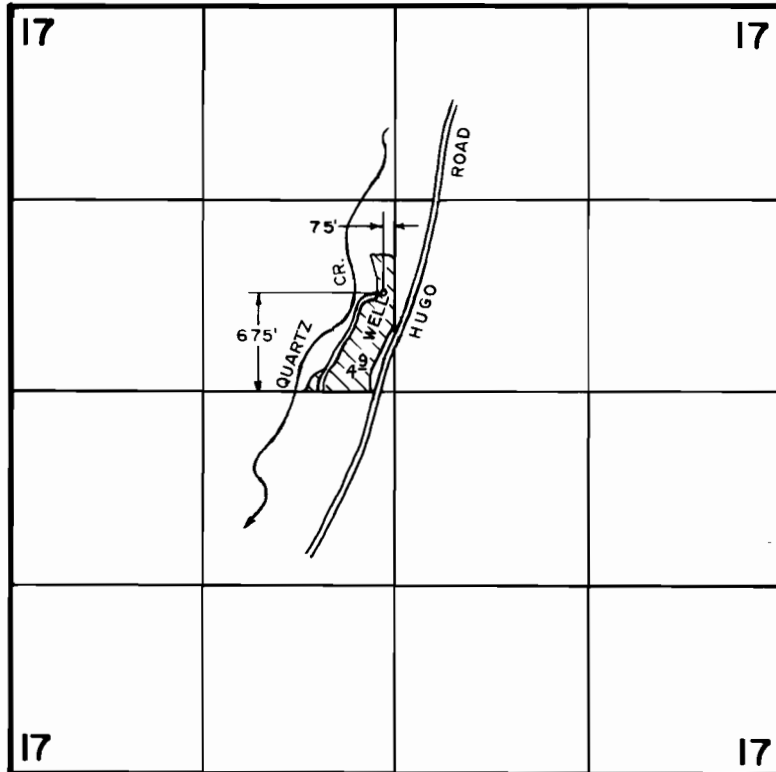

FINAL PROOF SURVEY
UNDER

Application No. **G-9361** Permit No. **G-8743**
IN NAME OF

WESLEY BANKS

Surveyed **SEPT. 28** 19**82**, by **B. SUZIE JAMES**

SCALE: 4" = 1 MILE