



**T.37S. R.5W. W.M.**

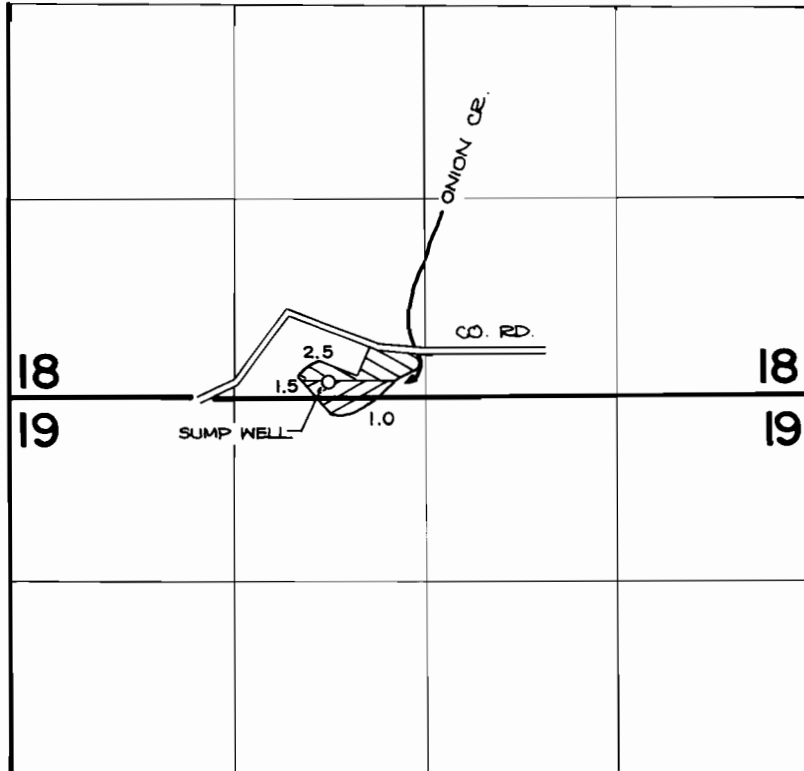

WELL IS LOCATED 110' N. AND 2200' E. FROM THE S.W. CORNER OF SECTION 18.



**PRIMARY**

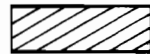

**SUPPLEMENTAL**

**FINAL PROOF SURVEY**

UNDER

Application No. **G-9514**. Permit No. **G-8937**.  
IN NAME OF

**LEWIS E. HAYES**

Surveyed **MAY 14**, 19**82**, by **B. SUND**