


T. 35 S., R. 7 W., W. M.

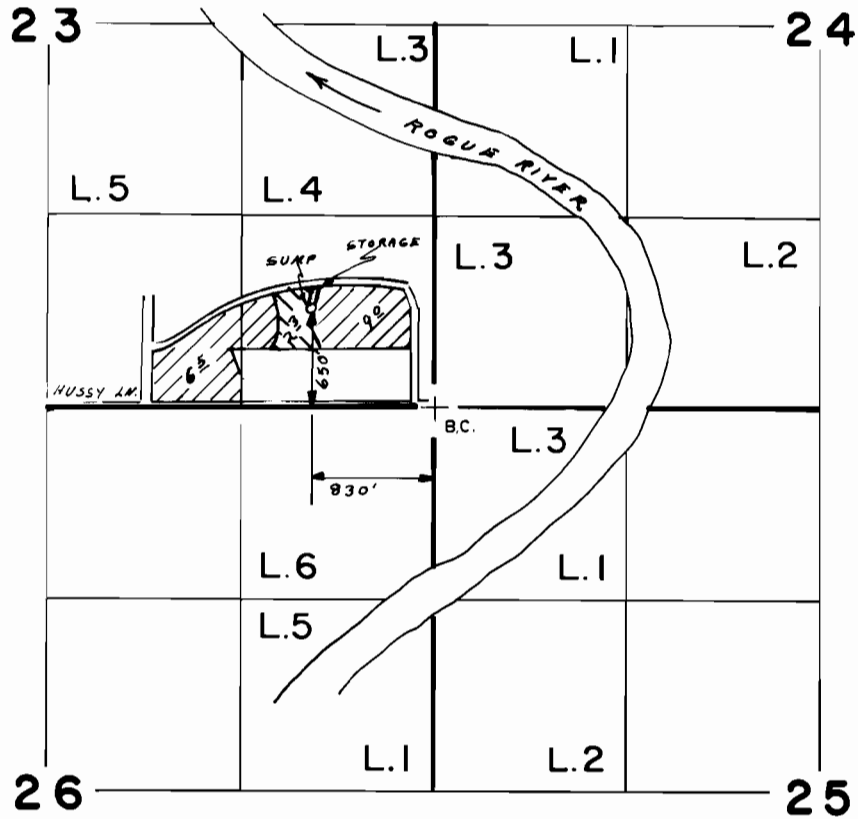

SCALE: 1" = 1320'

Primary

Supplemental

FINAL PROOF SURVEY
UNDER

Application No. **G-10136** Permit No. **G-9246**.
IN NAME OF

JUDITH NAN WEINER

Surveyed O.C.T. 24, 1985, by **B. S. JAMES**