



41262
55924

Angelo Gasperini
2262 Reclamation
Klamath Falls, Oregon 97601

T37S R5E
NW NW sec. 14

scale 1" = 100'

Summer Cbe. & Mac.

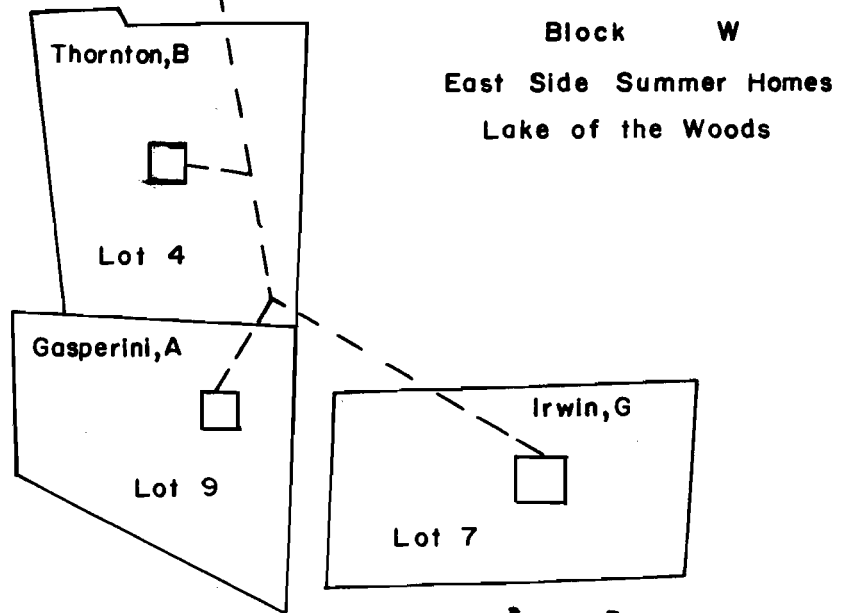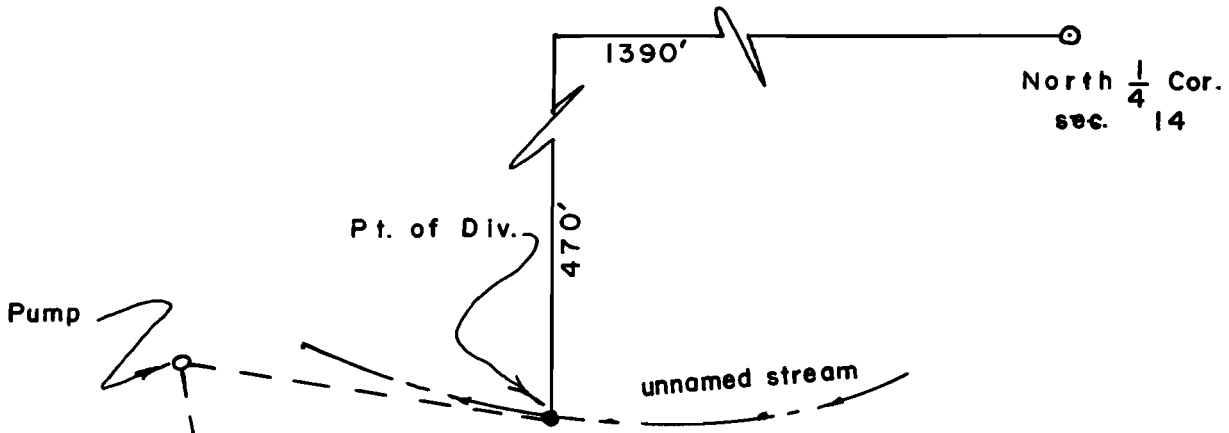

WATER RESOURCES DEPT
Klamath Falls, Oregon

Application No. 54982
Permit No. 41262