

JOHN D. MERRYMAN  
1801 FAIRMONT STREET  
KLAMATH FALLS, OREGON 97601

42353  
55925  
RECEIVED  
JUN 21 1977  
WATER RESOURCES DEPT  
SALEM, OREGON

LAKE of the Woods RECREATION AREA

T 37 S R 5 E


SW 1/4 Section 11

Scale 8" = 1 mile



Journal file: misc.

DIV. LOC: 540' N AND  
2345' W FROM S 1/4  
COR. SEC. 11

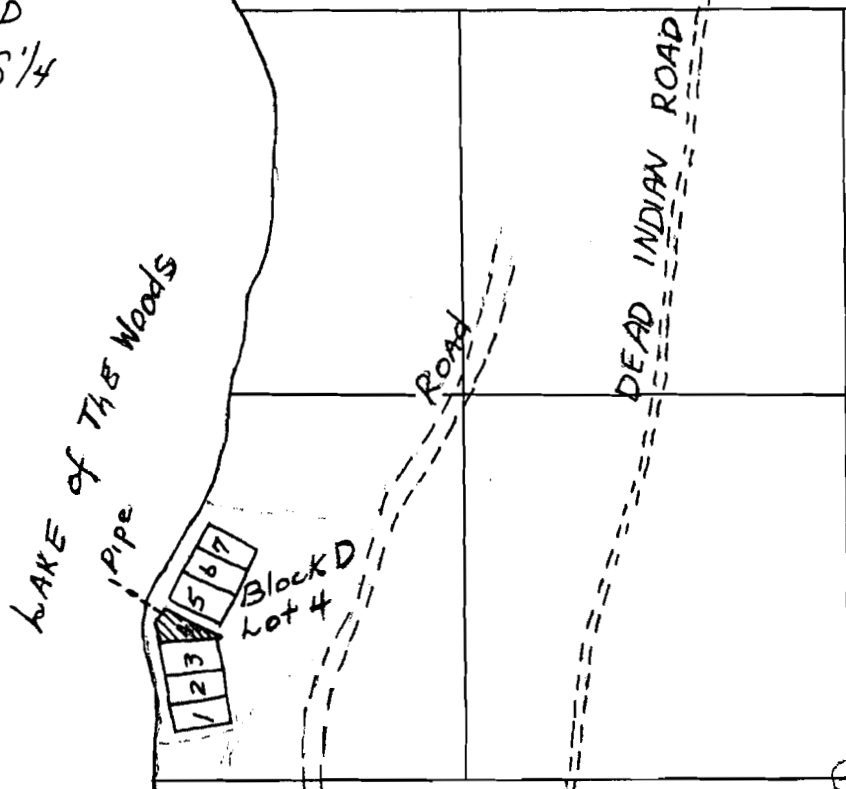

Application No. 56093  
Permit No. 42353