


Application No. 57769  
Permit No. 43462

57-167  
43462  
55927

T. 37 S., R. 5 E., W. M.

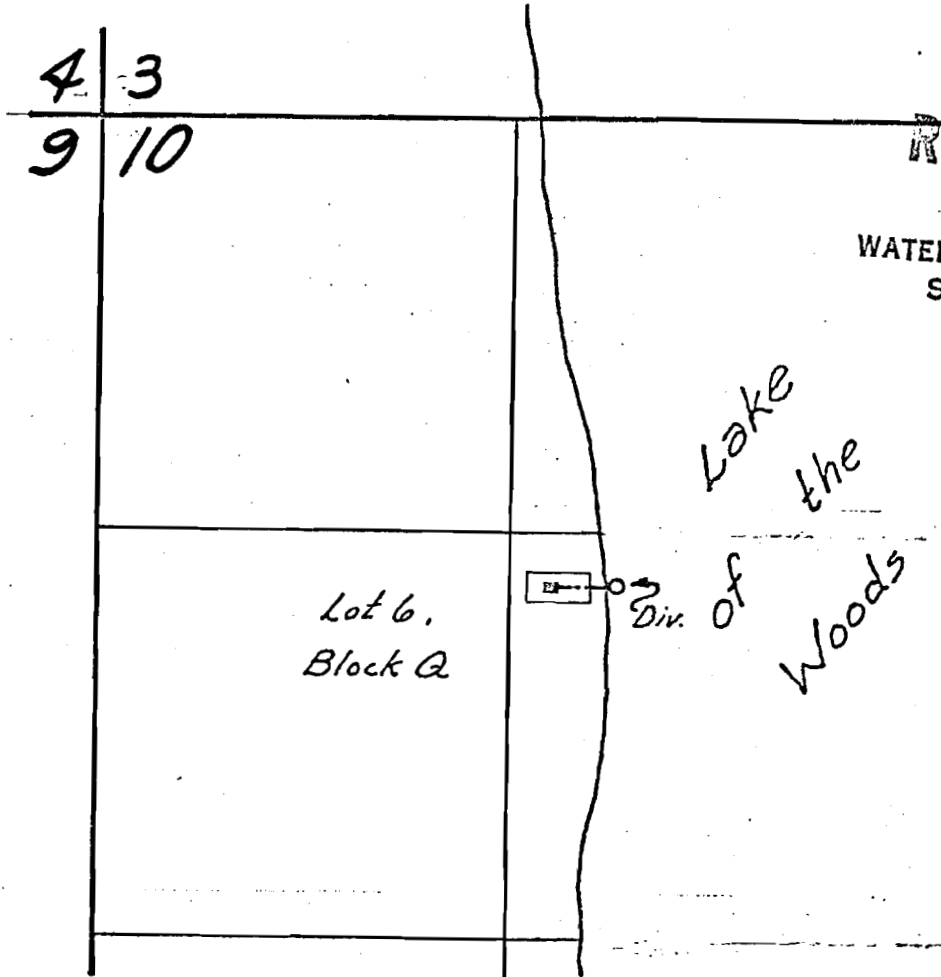

RECEIVED

AUG 8 1978  
WATER RESOURCES DEPT.  
SALEM, OREGON

Lake  
of  
the  
Woods

Lot 6,  
Block Q



Div. Pt. Loc.: 1467 ft. S., & 1408 ft. E. from  
NW cor. sec 10

Scale 1" = ~620'

Application Map for

Shirley S. Thompson

THIS MAP PREPARED BY:

*W. Brown*

FROM INFORMATION FURNISHED BY  
THE APPLICANT.

Journal Ctr. Misc.